


T. 27 S., R. 11 W. W.M.

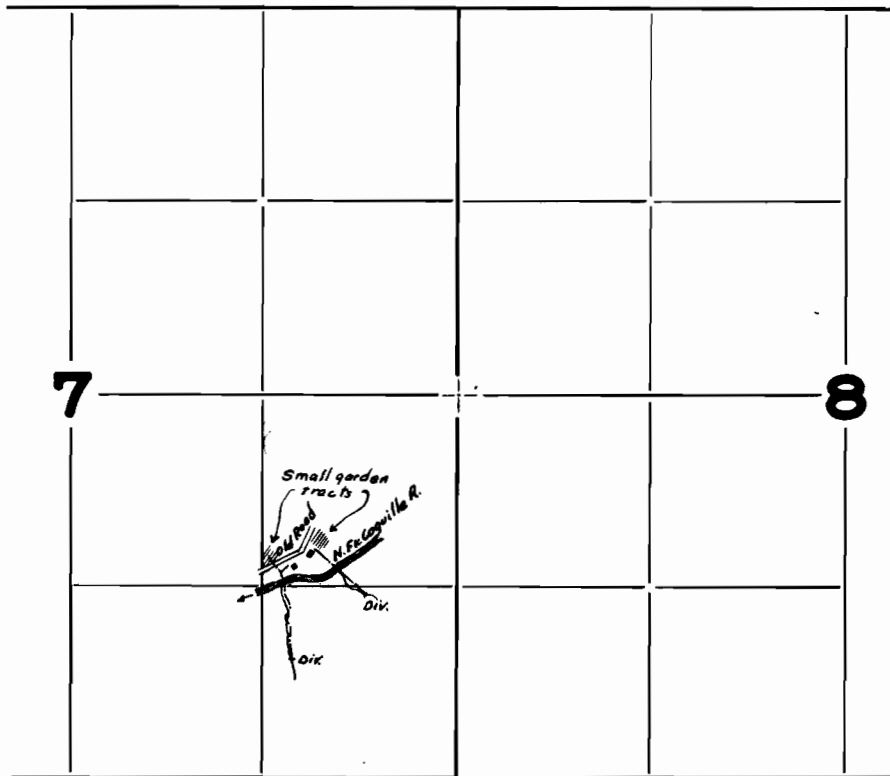

FINAL PROOF SURVEY
UNDER

Application No. 19402 Permit No. 14977

IN NAME OF

C. E. Watts

Surveyed Aug. 23 1943, by Geo. Maderman