


T. 25 S., R. 11 W. W.M..

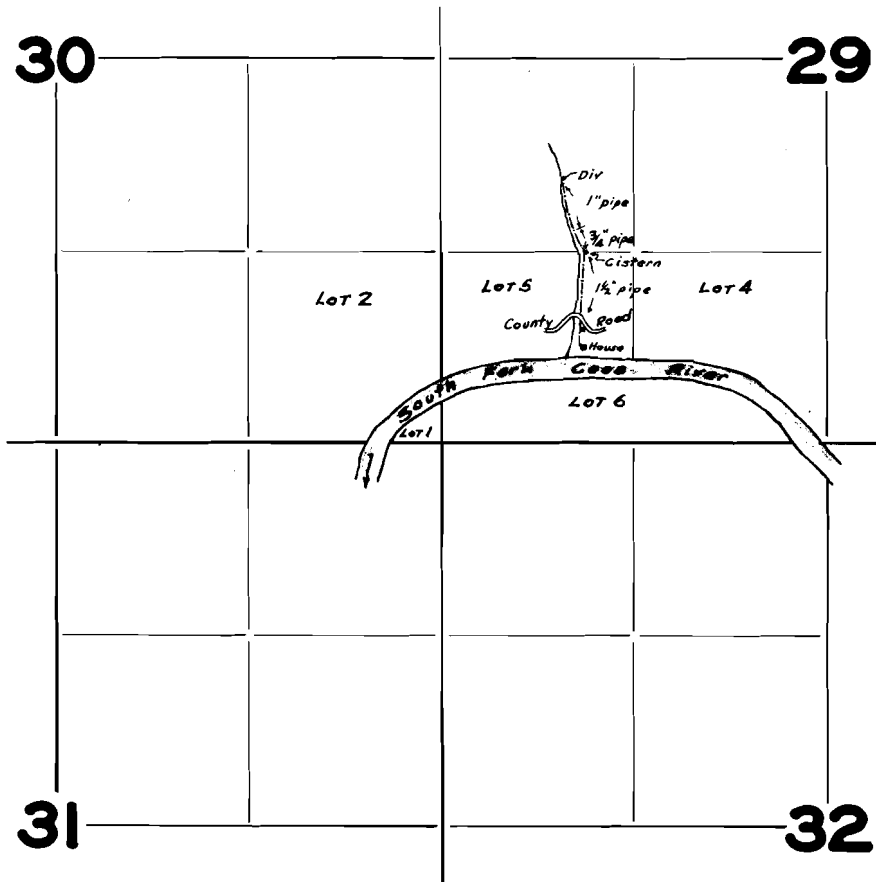

FINAL PROOF SURVEY  
UNDER

Application No. 19395 Permit No. 14984

IN NAME OF

Edward T. Stelle

Surveyed Aug. 20 1943, by Geo. J. Pedeman