


T. I S., R. I W. W.M.

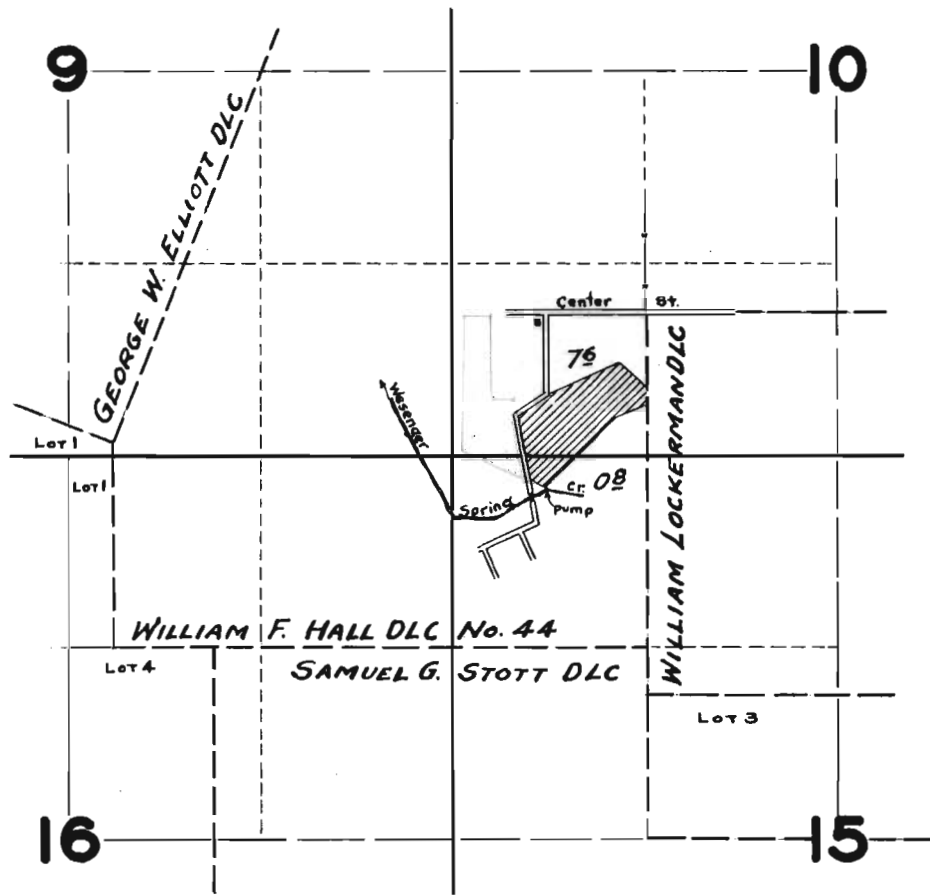

FINAL PROOF SURVEY

UNDER

Application No. 14366 Permit No. 15020

IN NAME OF


