


T. 4 S., R. 1 W. W.M.

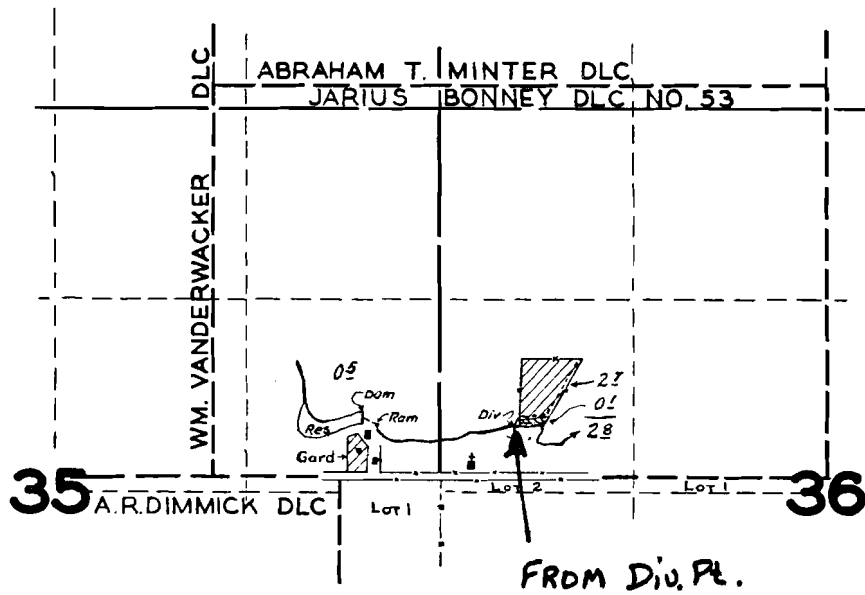

FINAL PROOF SURVEY

UNDER

Application No. R-19438 Permit No. R-769
19439 15037

IN NAME OF

C. C. Hepler

Surveyed June 24, 1942, by Geo. D. Paderman