


T. 18 S., R. 6 W. W.M.

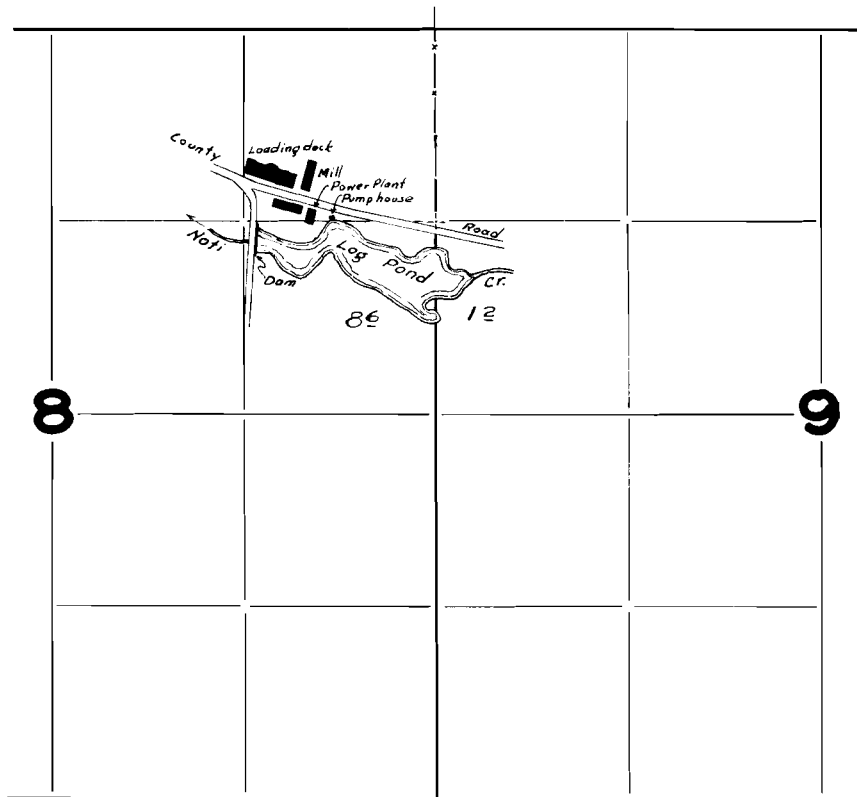

FINAL PROOF SURVEY

UNDER

Application No. R-19540 19541 Permit No. R-774 15172

IN FAVOR OF

Snellstrom Lumber Co.

Surveyed Aug. 10, 1943, by Geo. J. Aderman