


T. 27 S., R. 12 W. W.M.

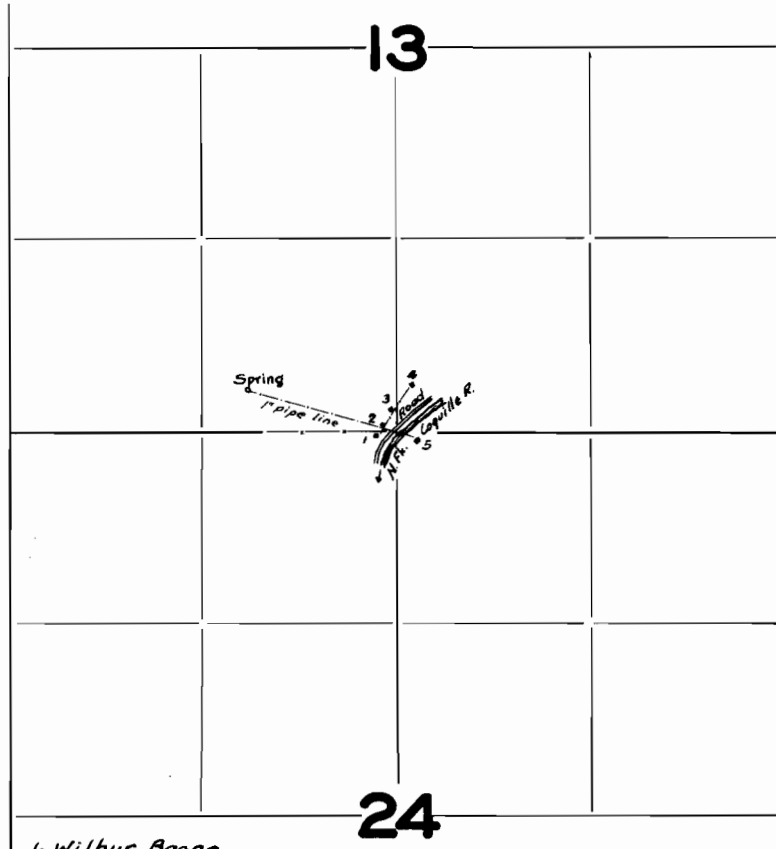

- 1- Wilbur Boone
- 2- Guy Davis
- 3- William Fanno
- 4- Ralph Boone
- 5- William D. Noah

**FINAL PROOF SURVEY**  
UNDER

Application No. 19582 Permit No. 15173

IN NAME OF

William D. & Pauline Noah

Surveyed Aug. 23 1943, by Geo. D. Pederman