


T. 32 S., R. 3 W. W.M.

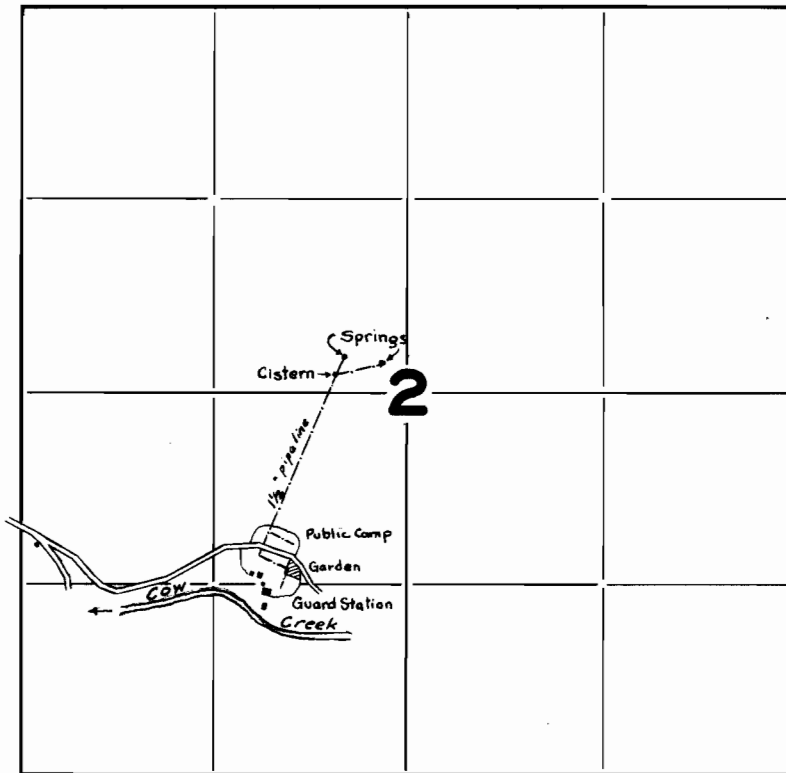

*Devil's Flat Forest Camp & Guard Station*

**FINAL PROOF SURVEY**  
UNDER

Application No. *19584* Permit No. *15174*

IN NAME OF

*U.S. Forest Service*  
*Umpqua National Forest*

Surveyed *Sept. 6* 1943, by *Scott Mademan*