


T. 27 S., R. 2 W. W.M.

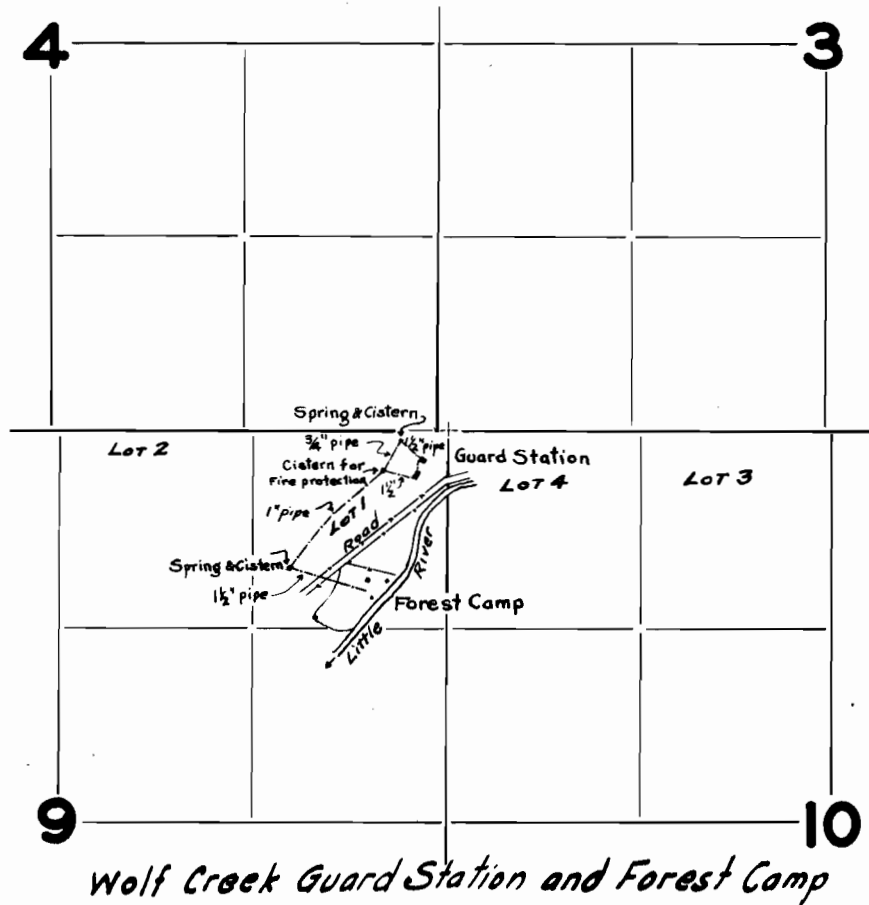

Wolf Creek Guard Station and Forest Camp

FINAL PROOF SURVEY

UNDER

Application No. 19615 Permit No. 15193
~~19616~~ ~~15194~~

IN NAME OF

U.S. Forest Service
Umpqua National Forest

Surveyed Sept. 9, 1943, by Geo. D. Derman