


T. 27 S., R. 2 W. W.M.

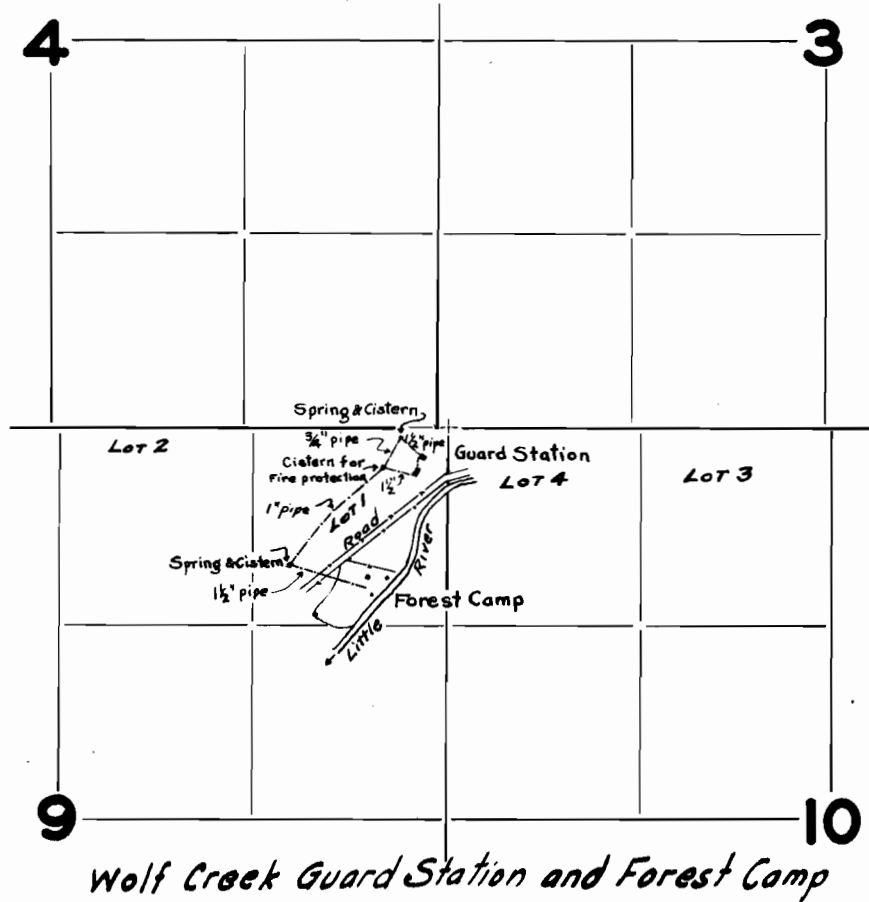

FINAL PROOF SURVEY

UNDER

Application No. 19615 Permit No. 15193  
19616 15194

IN NAME OF

U.S. Forest Service  
Umpqua National Forest

Surveyed Sept. 9, 1943, by Geo. D. Derman