


T. 26 S., R. 1 W. W.M.

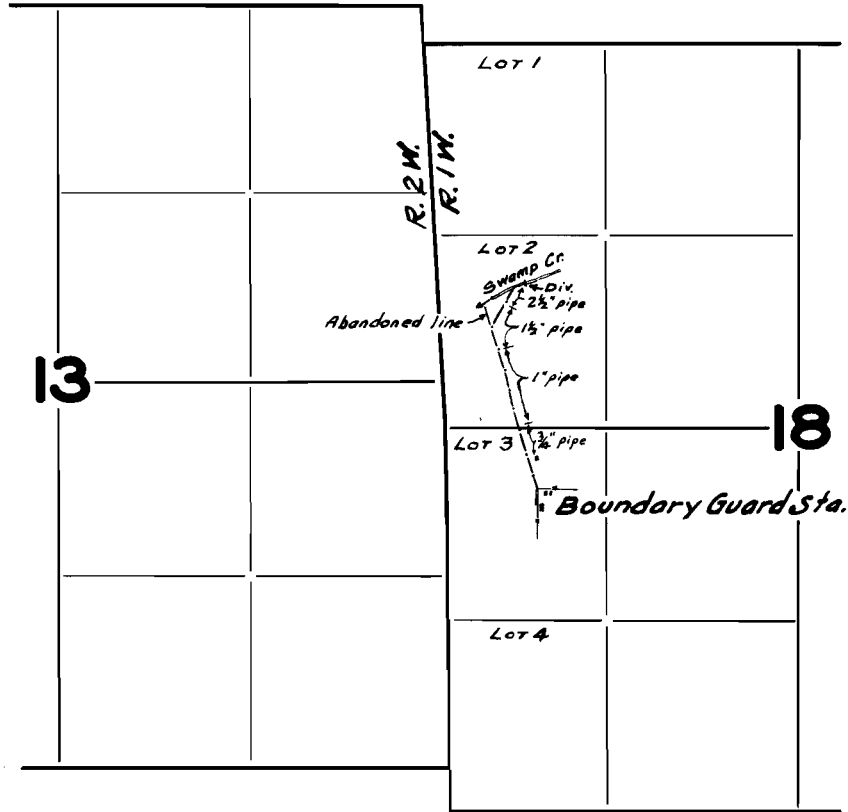

FINAL PROOF SURVEY  
UNDER

Application No. 19617 Permit No. 15195

IN NAME OF  
U.S. Forest Service  
Umpqua National Forest

Surveyed Sept. 9 1943, by Geo. J. Pederman