


# T. 27 S., R. 2 W. W.M.

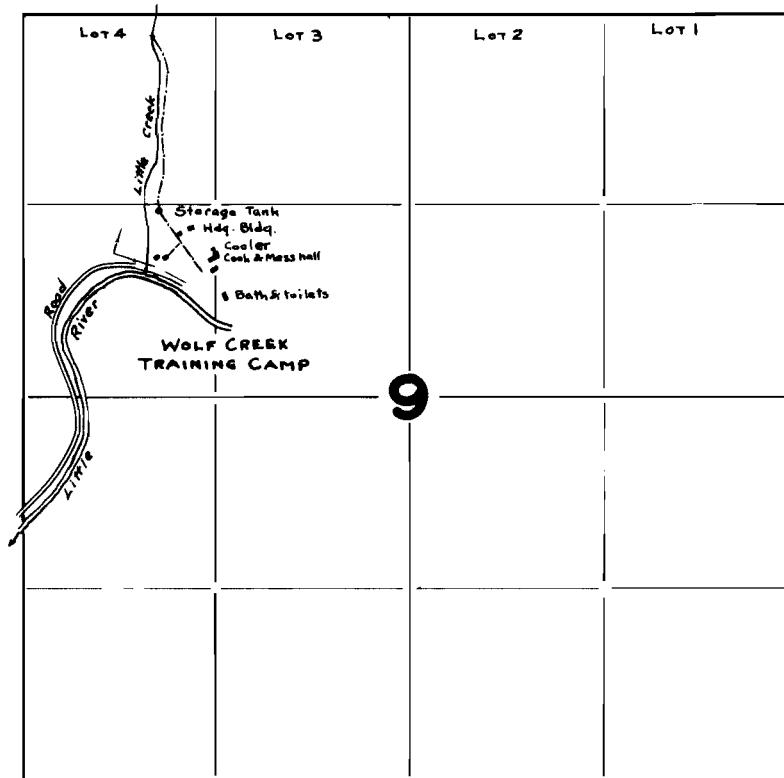

## FINAL PROOF SURVEY UNDER

Application No. 19622 Permit No. 15198

IN NAME OF  
U.S. Forest Service  
Umpqua National Forest

surveyed Sept. 9, 1943, by Geo. J. Anderson