


# T. 5 S., R. 1 W. W.M.

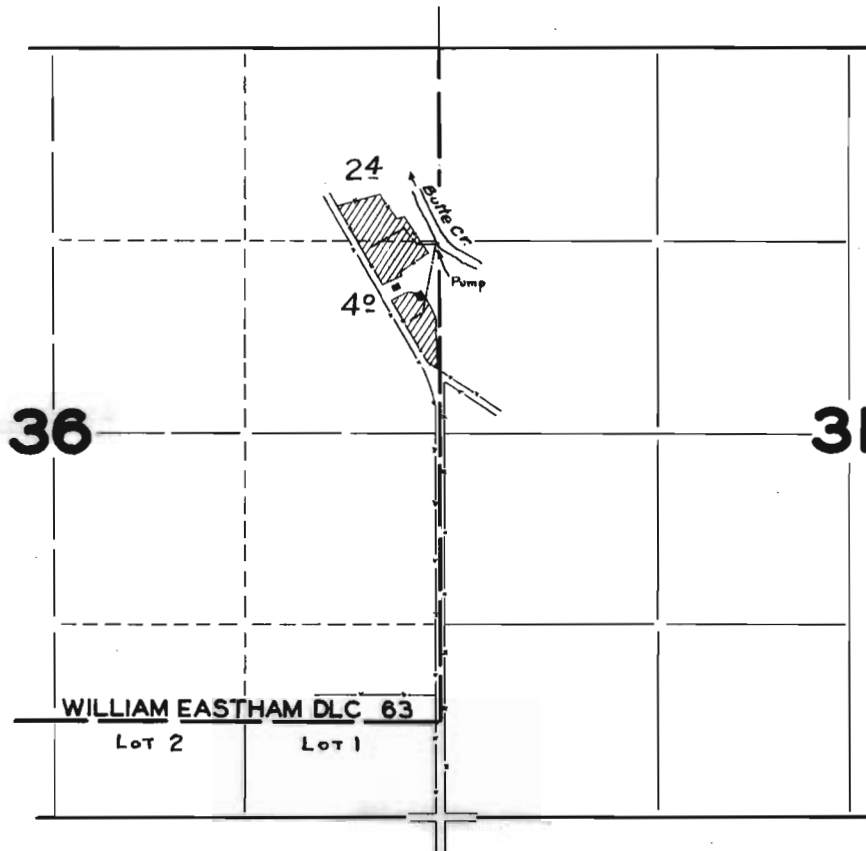

## FINAL PROOF SURVEY UNDER

Application No. 19642 Permit No. 15213

IN FAVOR OF

Henry J. Anderson

Surveyed Sept 20 1943, by Geo. W. Anderson