


# T. 41 S., R. 13 W. W.M.

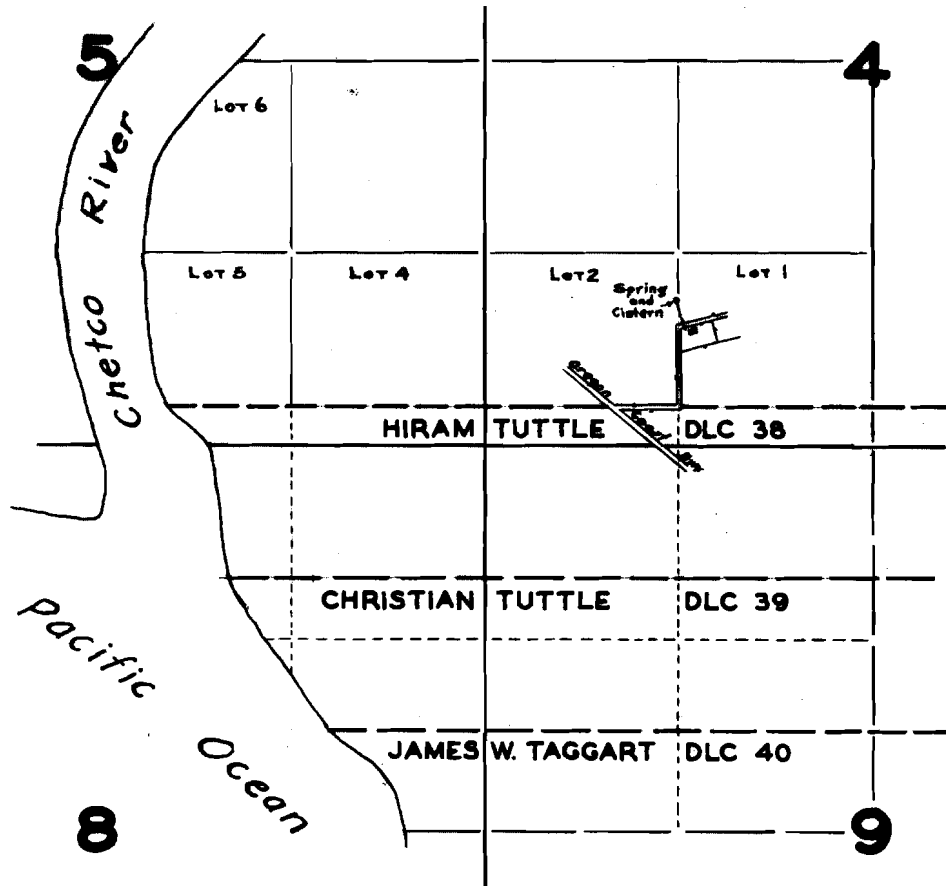

## FINAL PROOF SURVEY

UNDER

Application No. 19647 Permit No. 15233

IN NAME OF

Philip R. & Luella L. Trembly

Surveyed Sept. 1, 1943, by Earl W. Johnson