


T. 28 S., R. 11 W. W.M.,

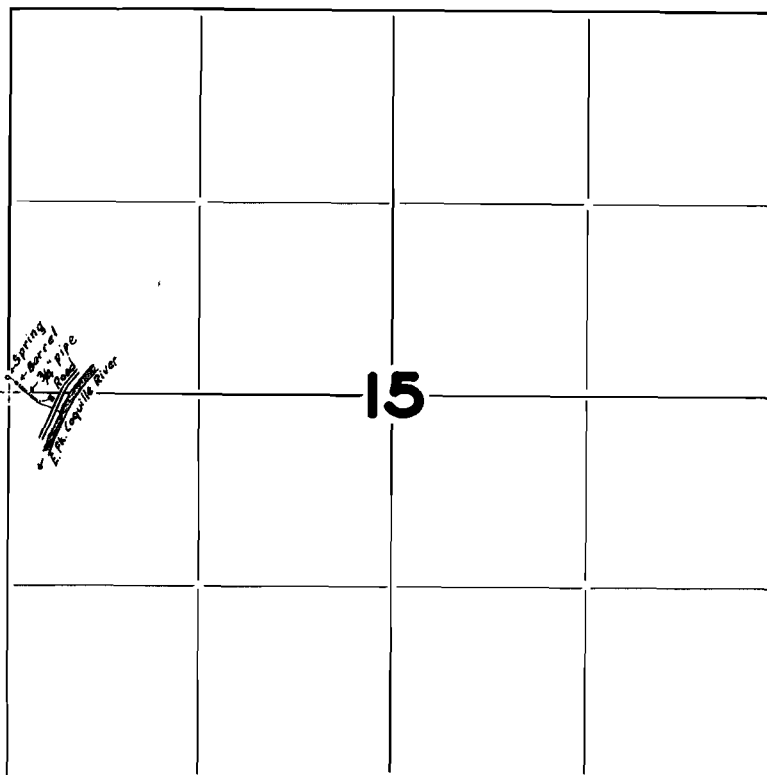

FINAL PROOF SURVEY

UNDER

Application No. 19674 Permit No. 15255

IN NAME OF

Fred Minard

Surveyed Aug 26 1943, by Geo. J. Adelman