


T. 22 S., R. 8 W.W.M.

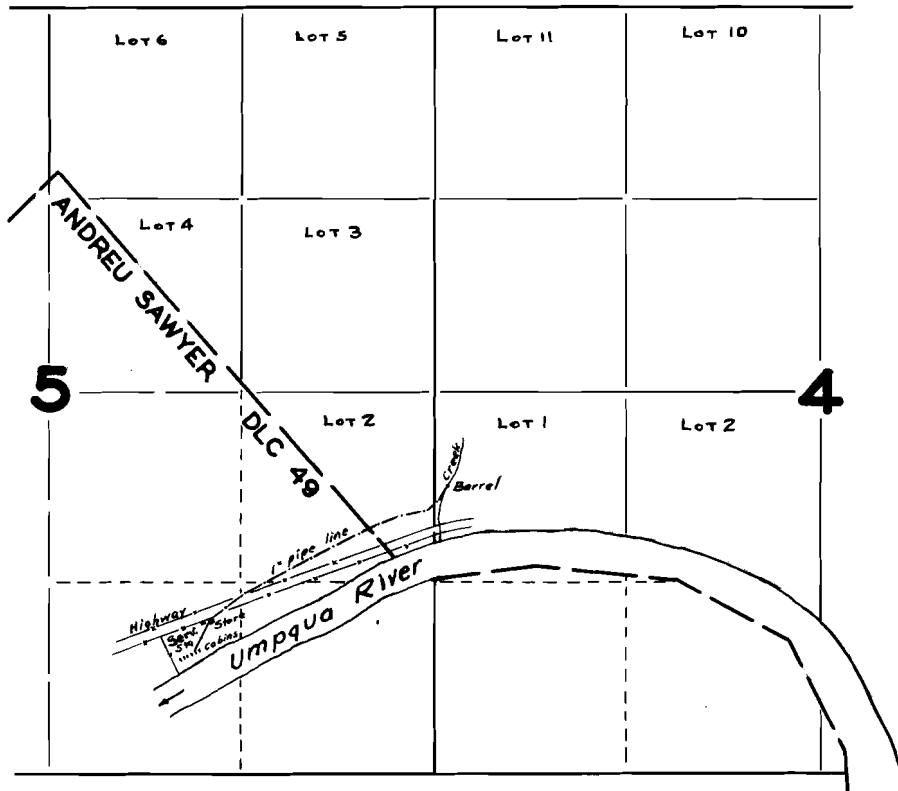

FINAL PROOF SURVEY
UNDER

Application No. 19695 Permit No. 15274

IN NAME OF

Frank B. Solomon

Surveyed Sept. 14 1943, by Geo. D. Aderman