


T.17^{AND} 18 S., R.10 W. W.M.

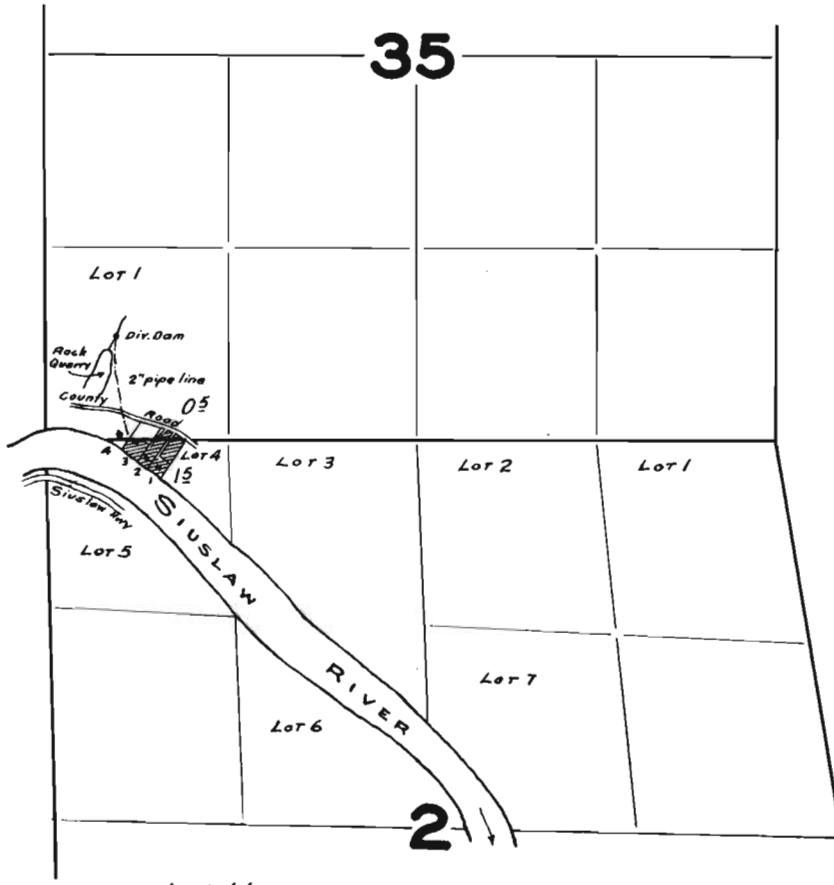

- 1 - Frank Fields
- 2 - Davidson
- 3 - J. E. Cupp
- 4 - Irvin R. Fox

FINAL PROOF SURVEY
UNDER

Application No. 19704 Permit No. 15282

IN NAME OF

J. E. Cupp et al

Surveyed Aug. 11, 1943, by Geo. D. Adelman