


T. 37 S., R. 15 W. W.M.

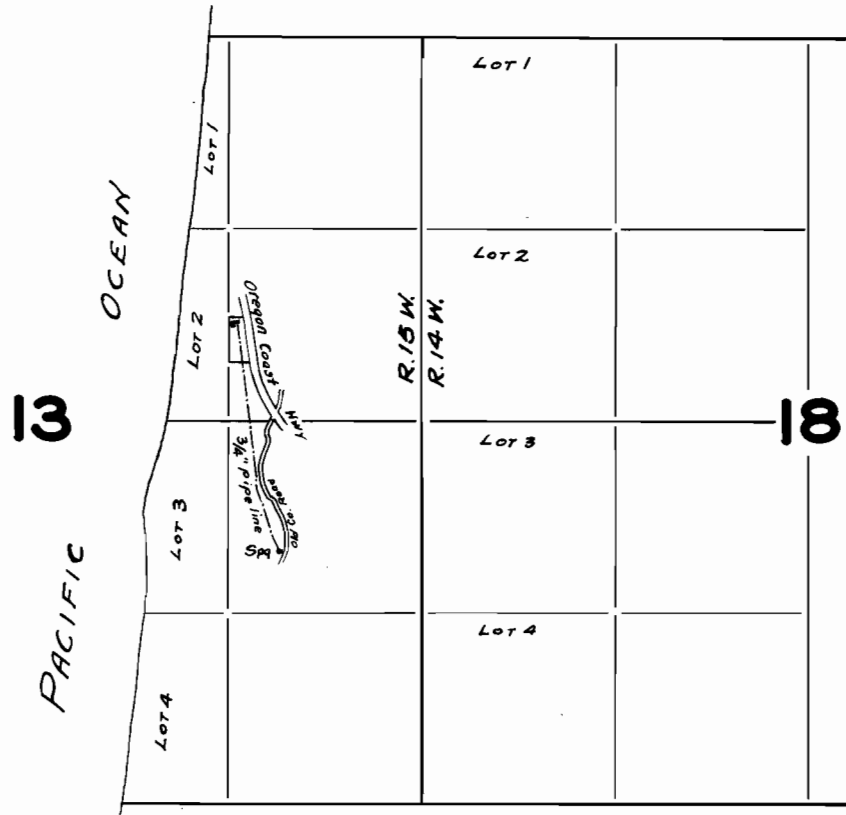

FINAL PROOF SURVEY
UNDER

Application No. 19746 Permit No. 15332

IN NAME OF

Walter Aberwald

Surveyed Sept. 2 1943, by Geo. V. Naderman