


# T. 9 S., R. 1 E. W.M.

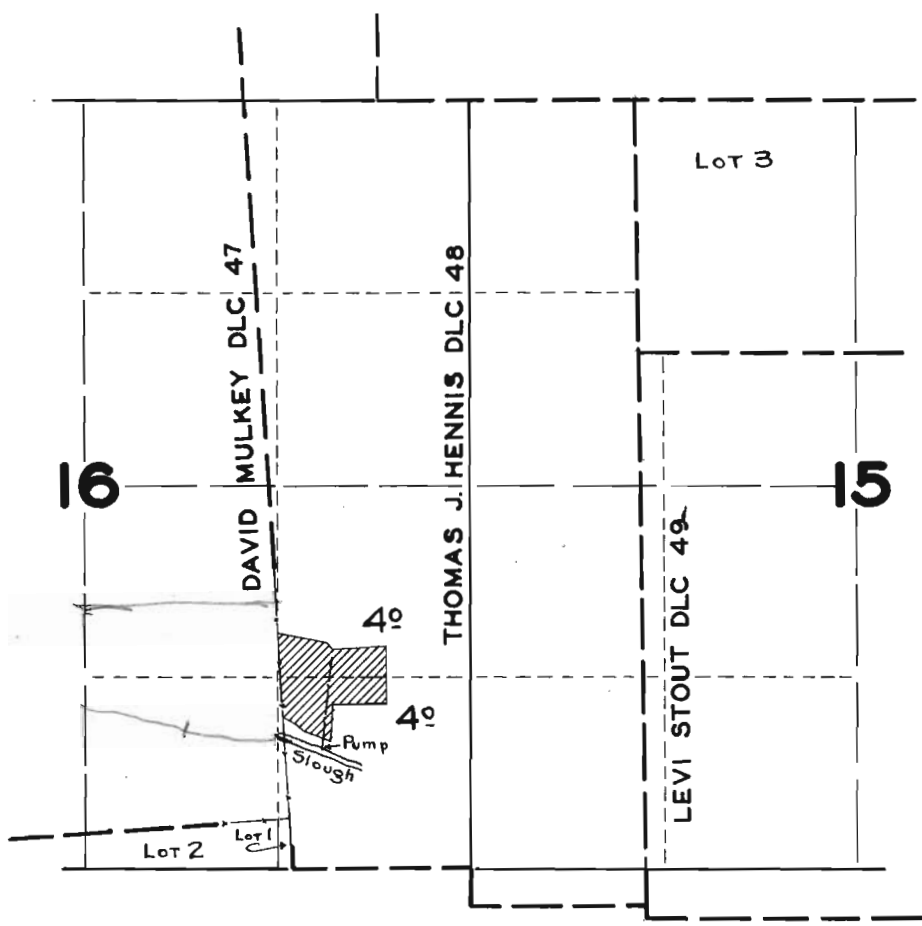

## FINAL PROOF SURVEY UNDER

Application No. 19766 Permit No. 15380

IN NAME OF

J. K. McCall

Surveyed July 30 1943, by Geo. Maderman