


SECTION
SW $\frac{1}{4}$ SE $\frac{1}{4}$
Section 36

TOWNSHIP 3 S., RANGE 43 E., W. M.

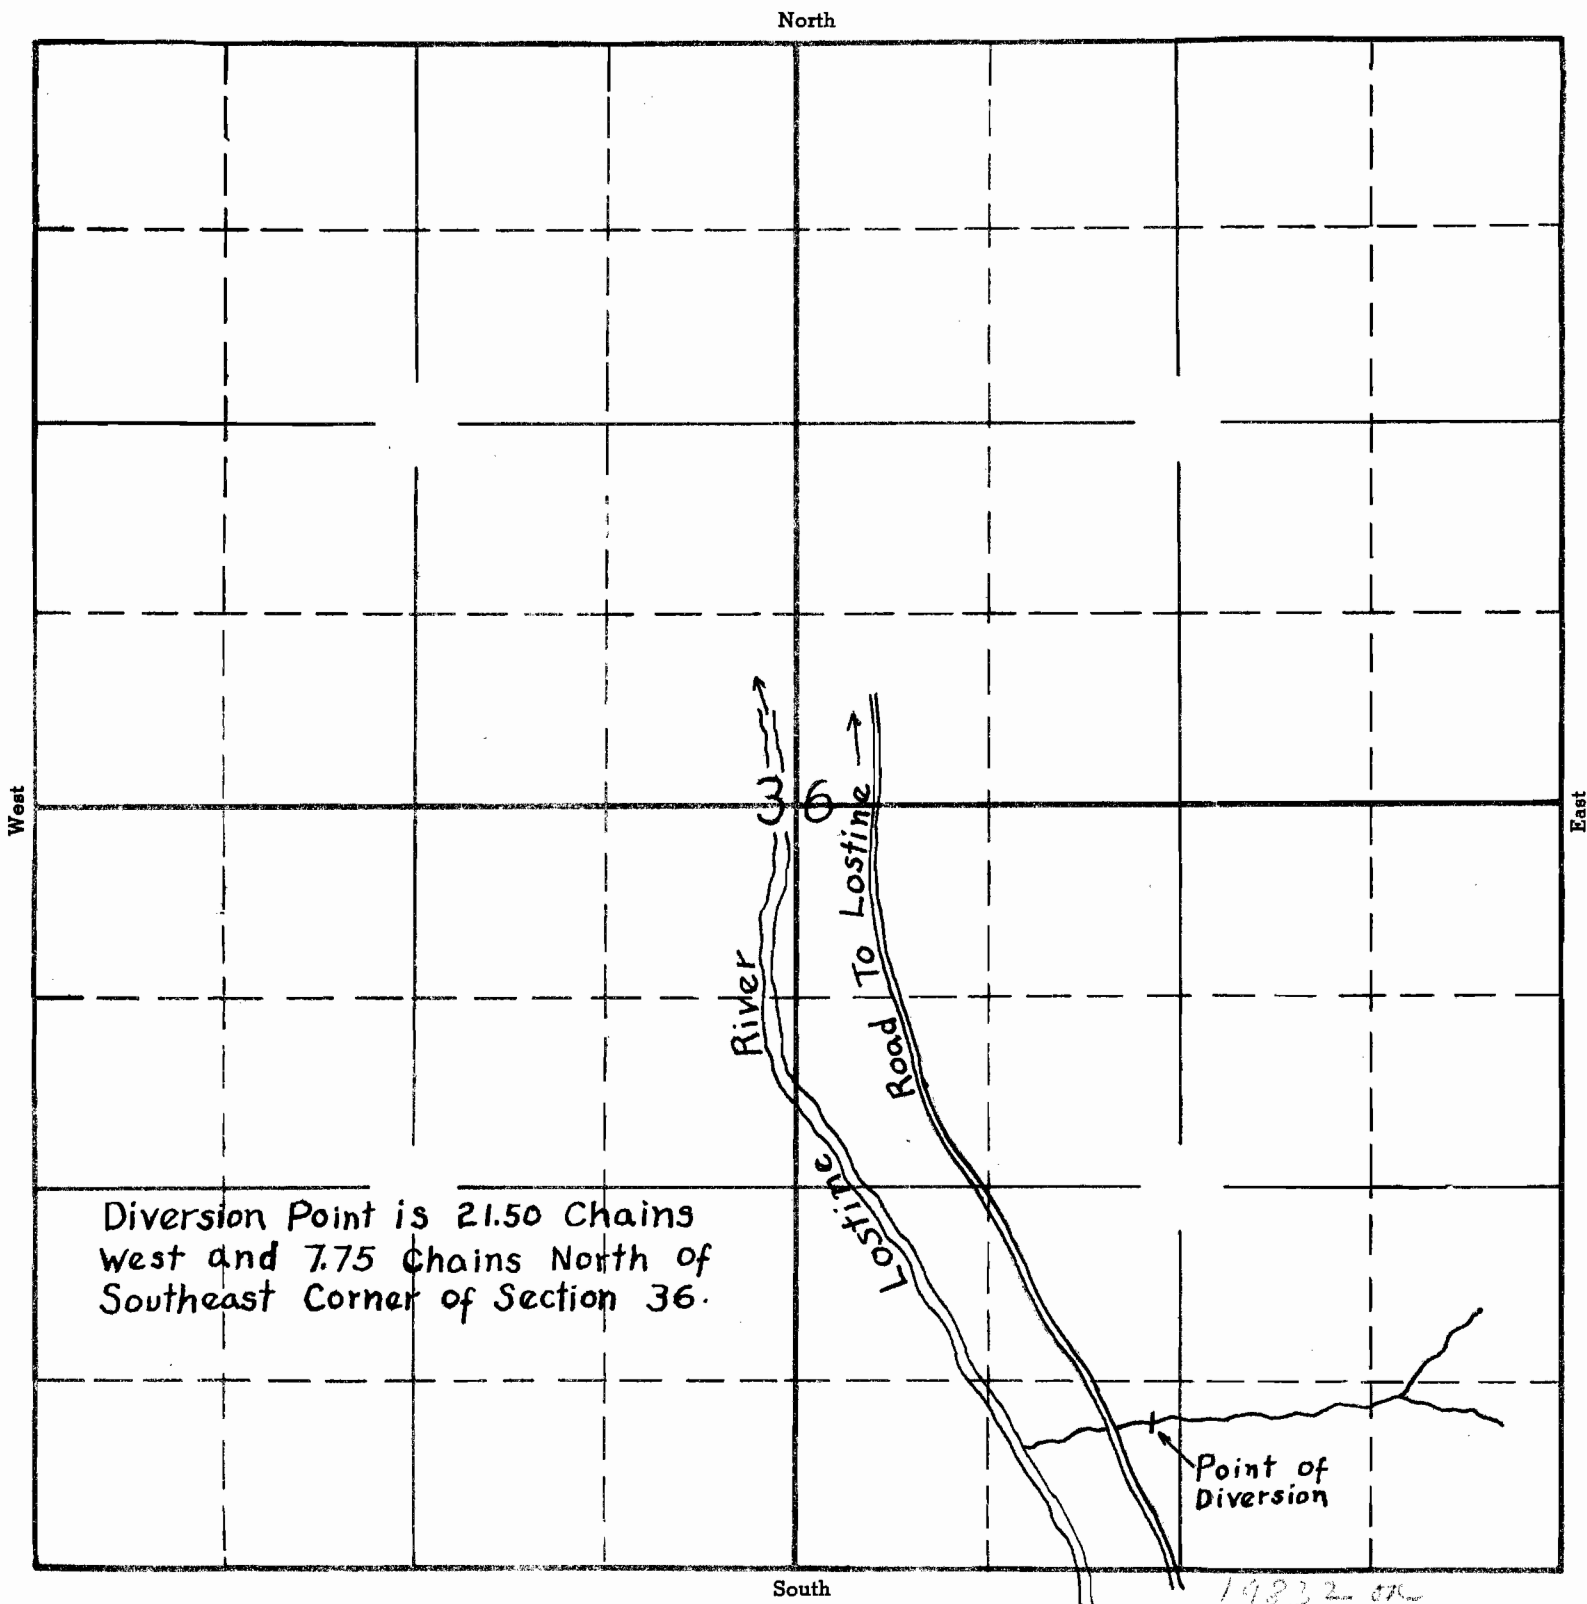

Scale 8" = 1 Mile.

19832 OK
8-37
APPLICATION No. 19832
PERMIT No. 15405

11/20/42
834