


# T.16 S., R. 6 W. W.M.

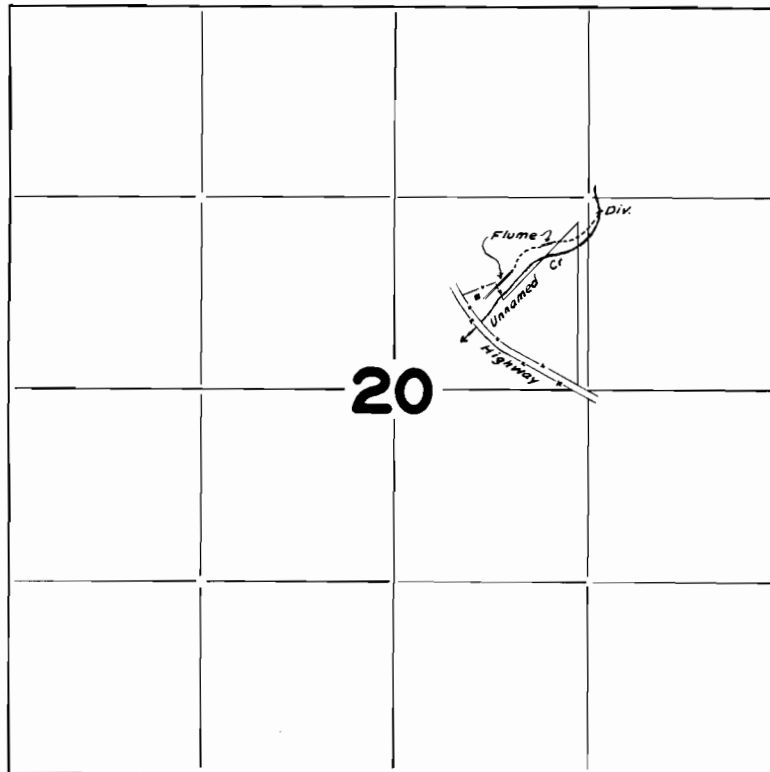

PLAT 15463

App. No. 19891

W. H. Dandy

Surveyed Aug. 6, 1943, by Geo. Spideman