


T. 18 S., R. 12 W. W.M.

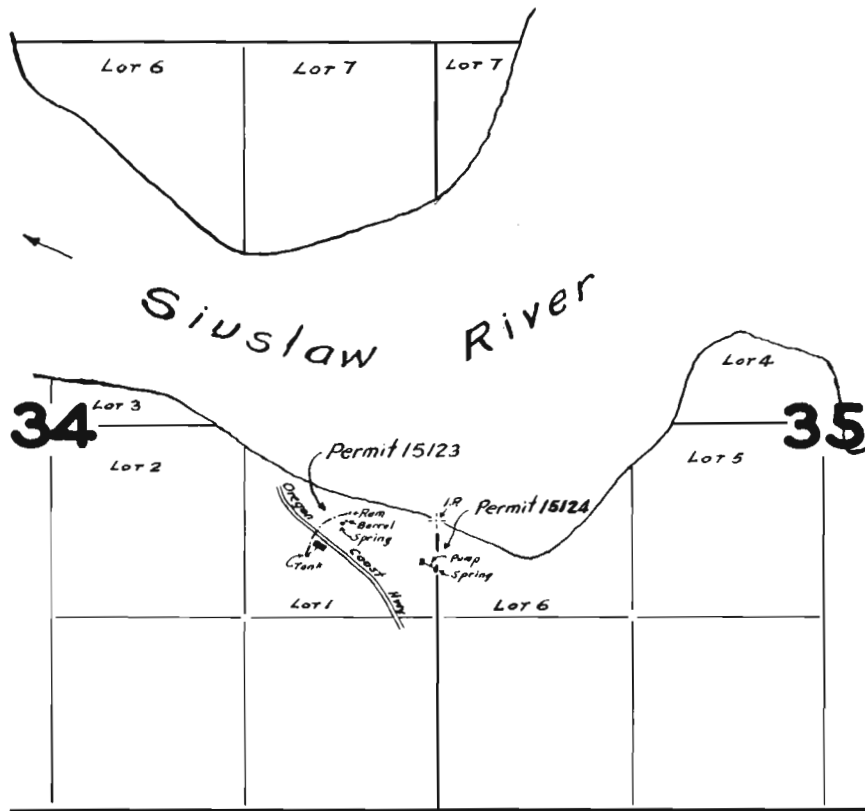

FINAL PROOF SURVEY
UNDER

Application No. ~~19533~~ ¹⁹⁵³⁴ Permit No. ~~15123~~ ¹⁵¹²⁴

IN NAME OF

Fred H. & Gertrude E. Schneider

Surveyed Aug. 12, 1943, by Geo. J. Aderman