


N

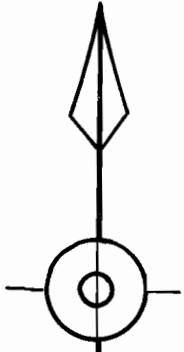

Scale - 1" = 200'

FIRST BROOKSIDE ADDITION

MILL POND

18 17
19 20

N 12° E - 428.0'
R. Proposed Pipe Line 3

EAST ST OR DIXONVILLE ROAD

IVAN ST.
North 524.3'

N 45° W - 205'
West Intake
DEER CREEK
N 45° W - 200'

S 60° 15' W
995.6'

N.W. Cor. D.L.C. No 40
Tp. 27 S - Rg. 5 W. W.M.

THOS STEVENS D.L.C. No 40.



I Edwin S Woodford of Salem Oregon do hereby Certify that this map was made from notes taken during an actual survey made by me on July 31 1943 and that it correctly represents the works described in the accompanying application together with the location of streams and other ditches in the immediate vicinity.

Edwin S Woodford

Oregon No. 622

Registered Professional Engineer.

Dec. 8, 1919.

Date of Registration.

20053
10-36

R-22223

Application No. 20053
Permit No. 15619