



,

[illegible]

Township 4 S.

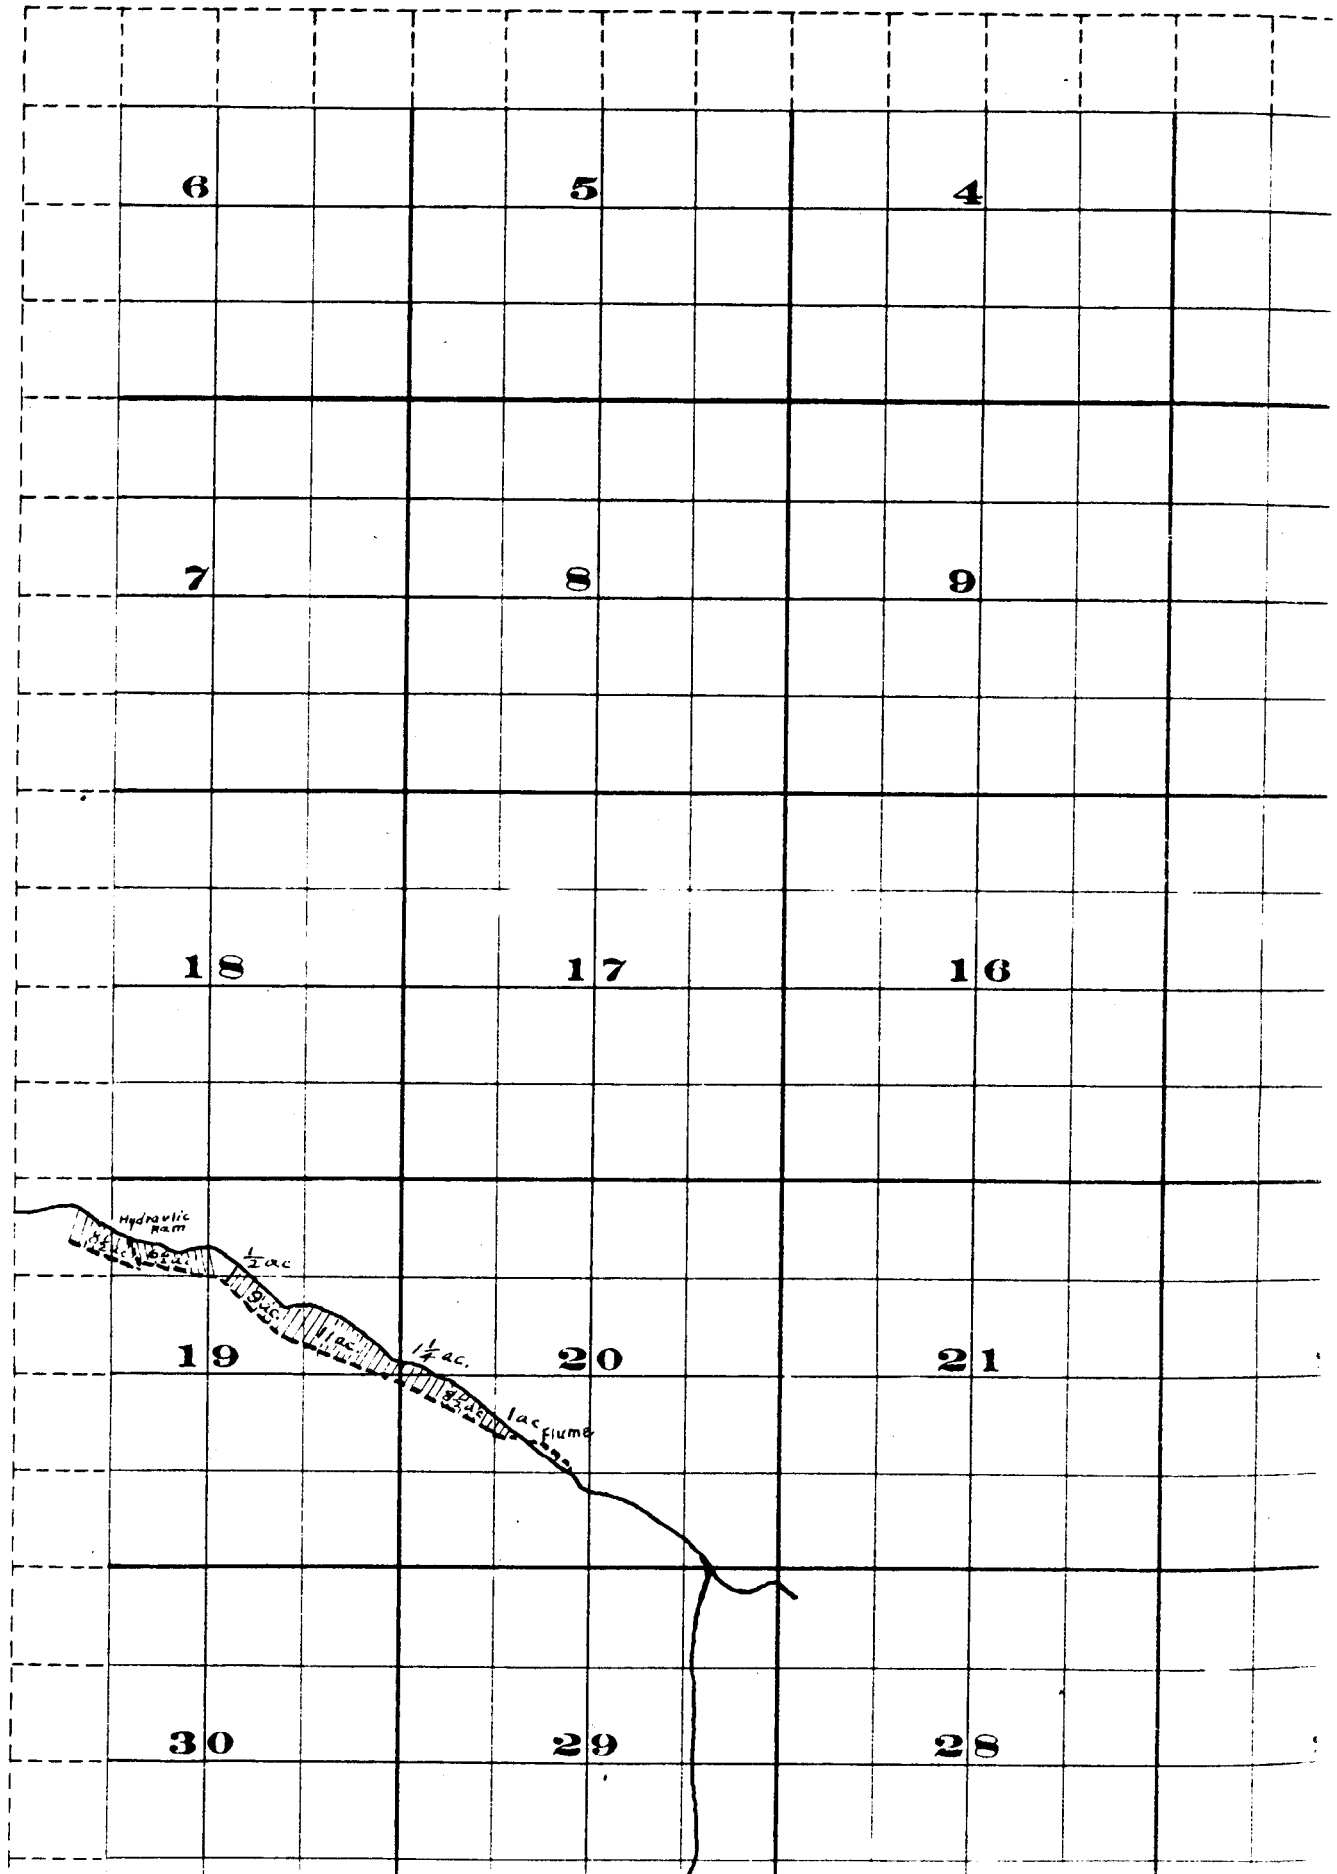

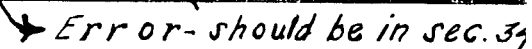

Examined July 14, 1909.

