


T. 1N. R. 3E. W.M.

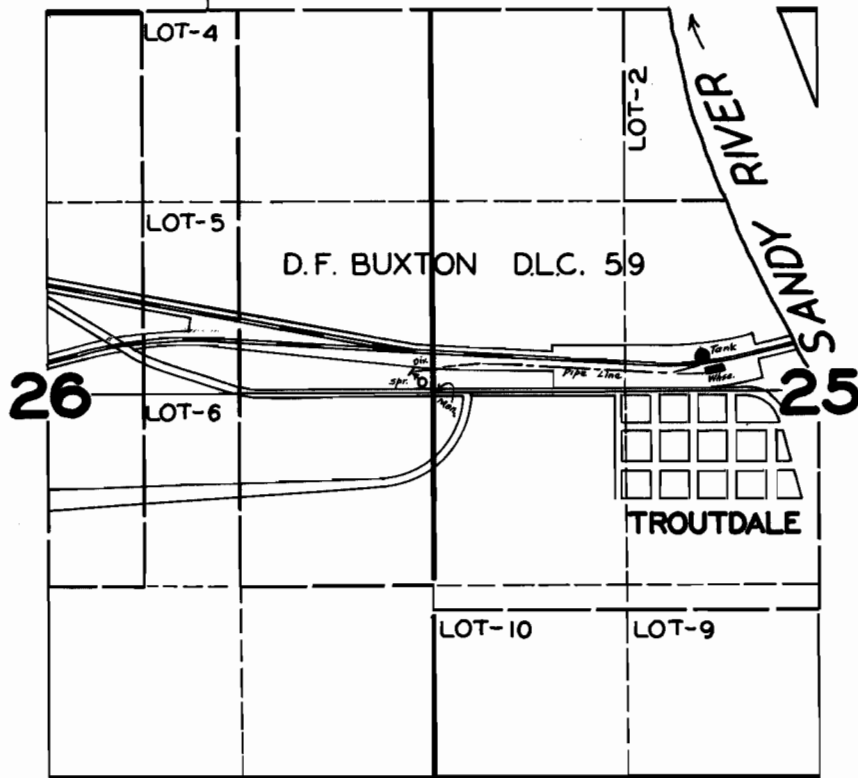

FINAL PROOF SURVEY UNDER

Application No. 19879 Permit No. 15452

IN NAME OF

OREGON-WASHINGTON RAILROAD & NAVIGATION CO.

Surveyed MAR. 2, 1945, by

J. B. Russell