Hood F County

SCALE 1:4800

200 0 200 400
FEET

0 10 20
KILOMETER

Cancelled No's.
501 1302
400 1303
401
405
4100
4200
4300
4400
4500
700
200
2000
2502

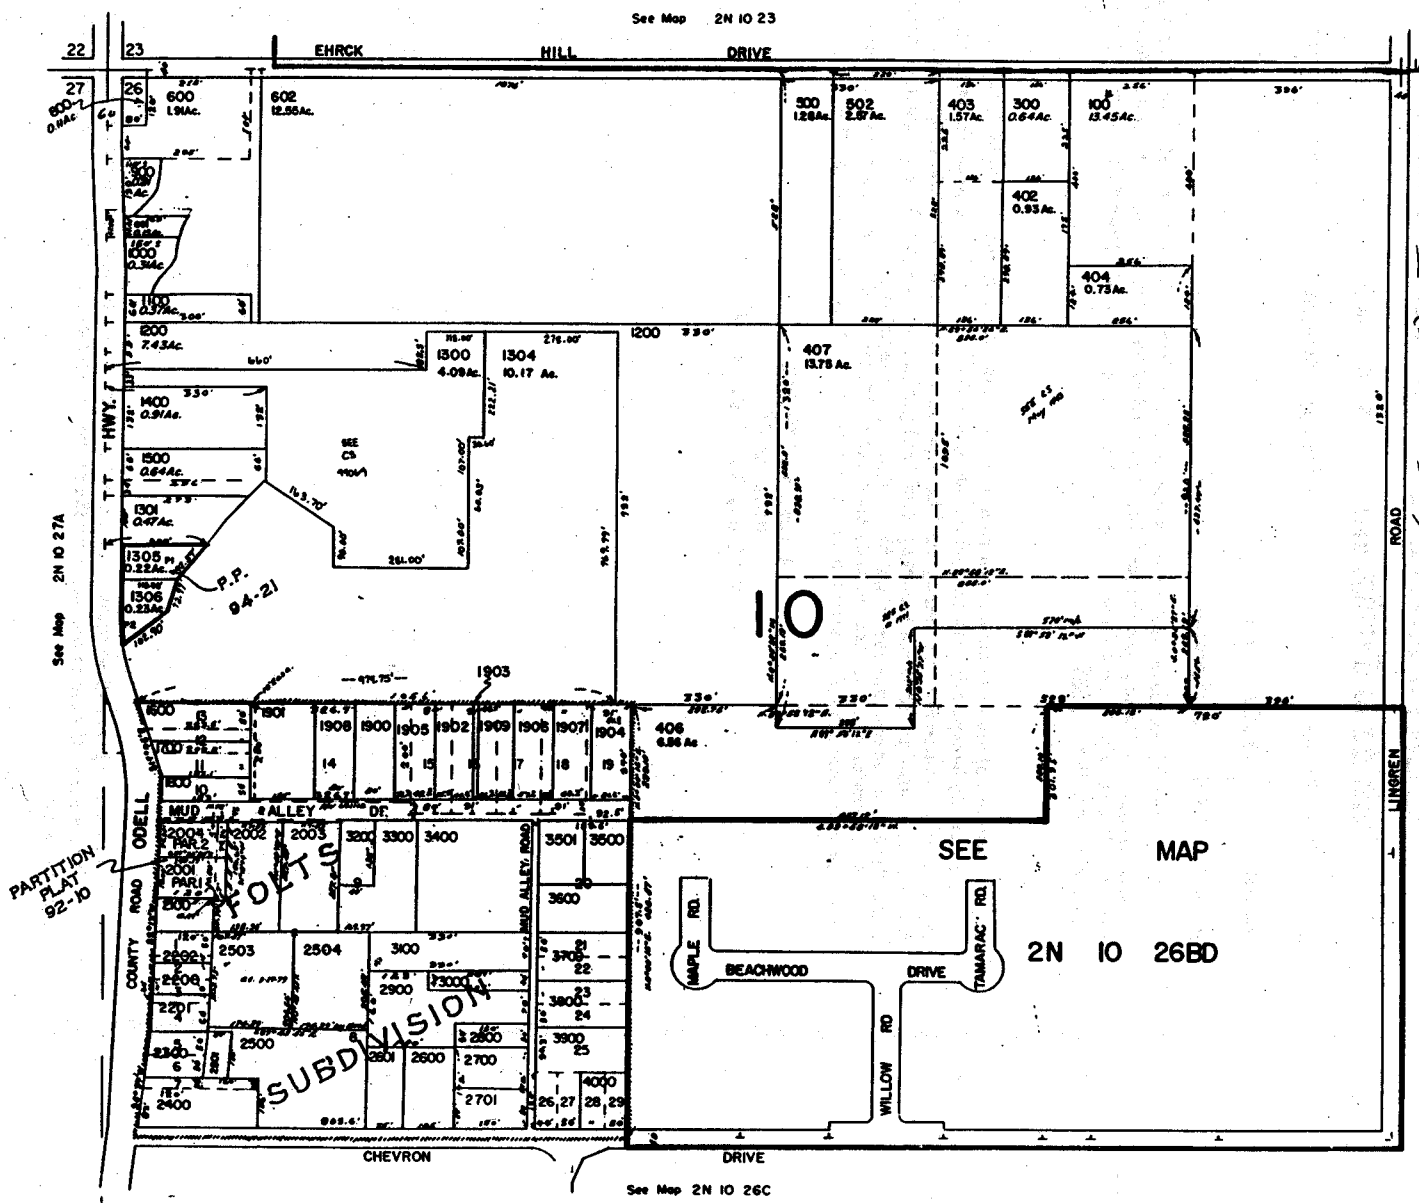

RECEIVED
FEB 13 1995
DEPT. OF REVENUE
STATE OF OREGON

I believe this is Parcel 5- this water right. Information under Cert. 14978 shows Lot with Kemp name on it. UNT

See Map 2N 10 26 11/6/95 Talked to Darlene Roberts. She was requesting info. RH Kemp used to own 1400 and they have things in have with RH Kemp name on UNT

2N 10 26B