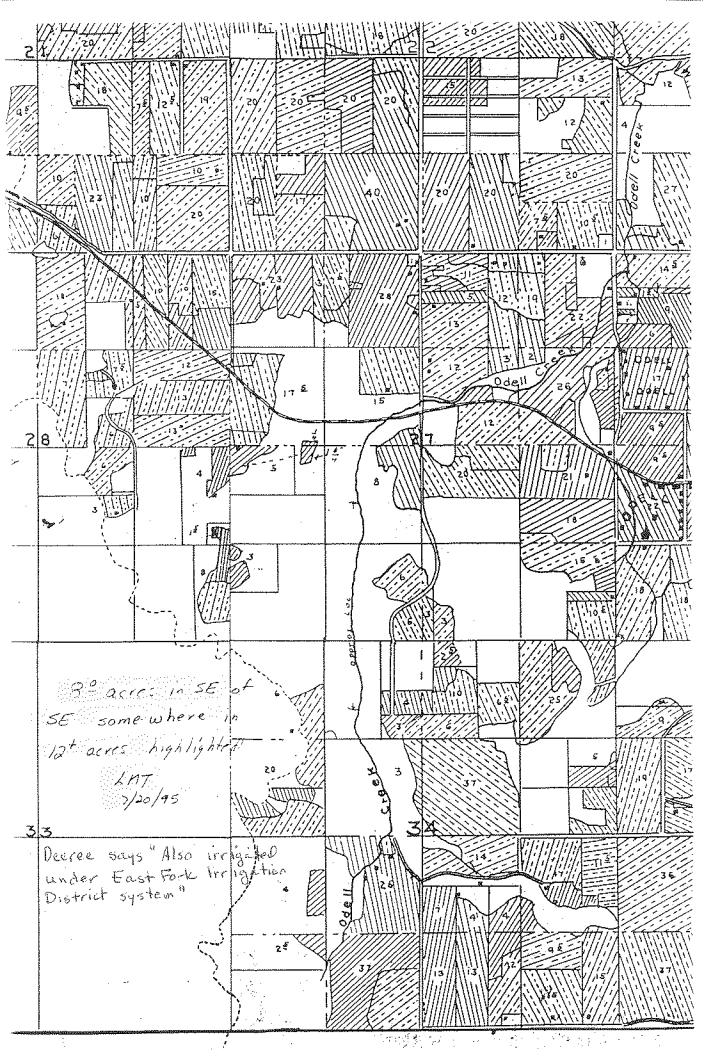

8° acres in SE of SE somewhere in 12th acres highlighted

LMT 7/20/95

Decree says "Also irrigated under East Fork Irrigation District system"