


Ocell Creek

Neil Creek

Spring

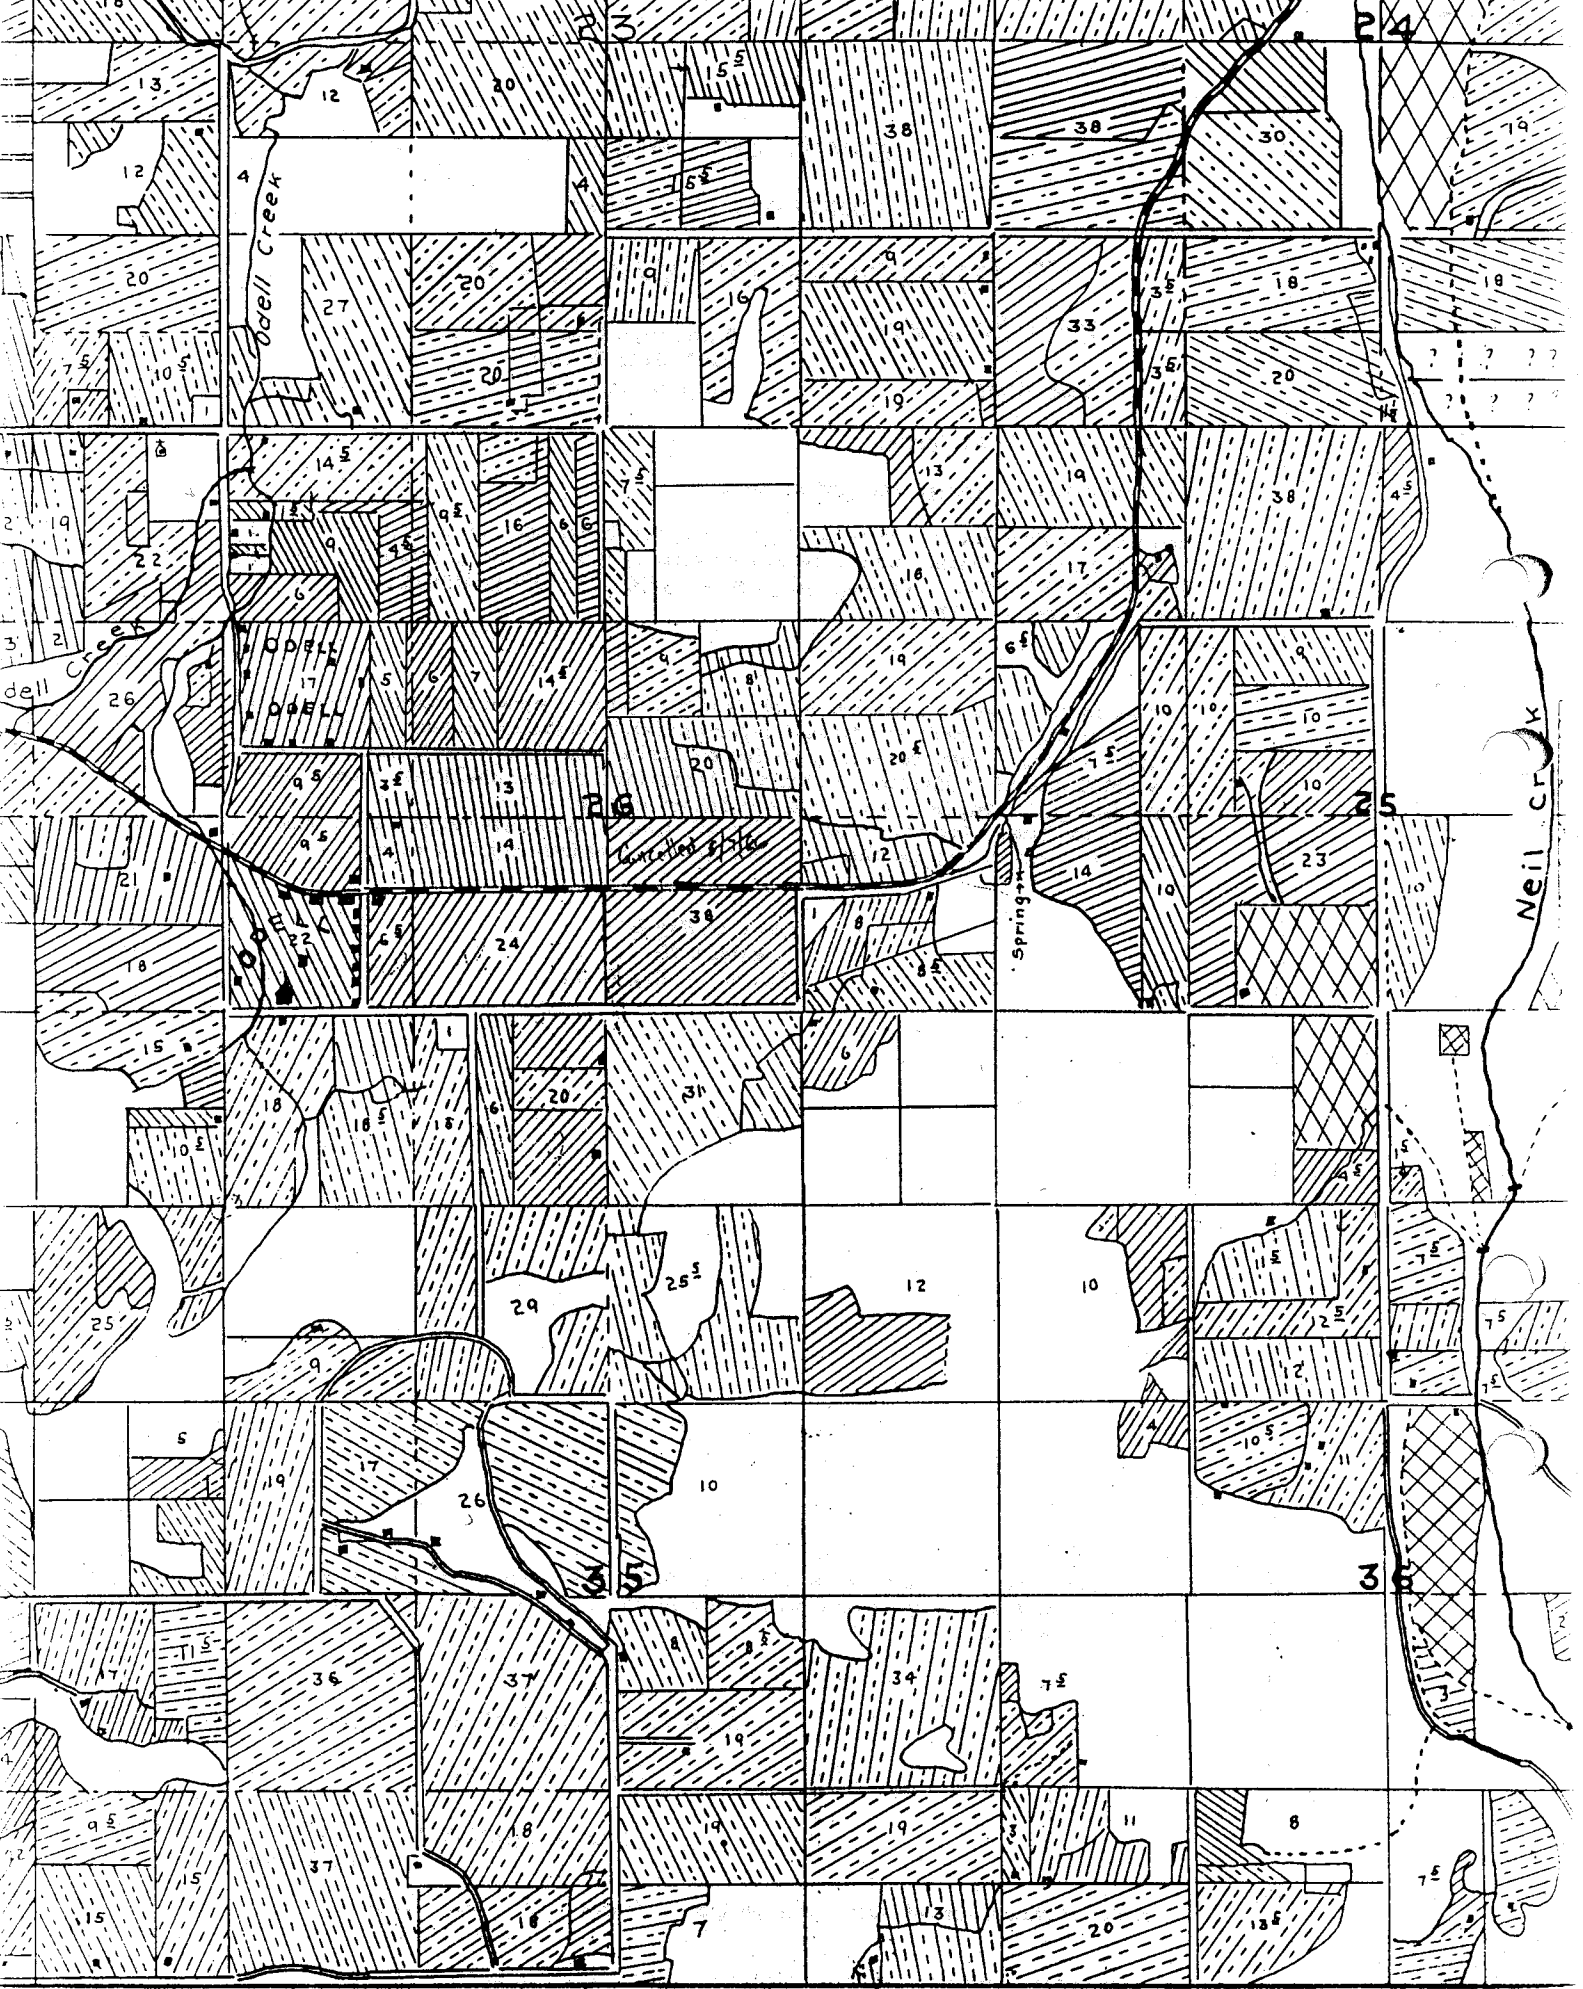

Ocell Creek

Neil Creek

Spring