


T. 6 S..R. 3 W. W.M.

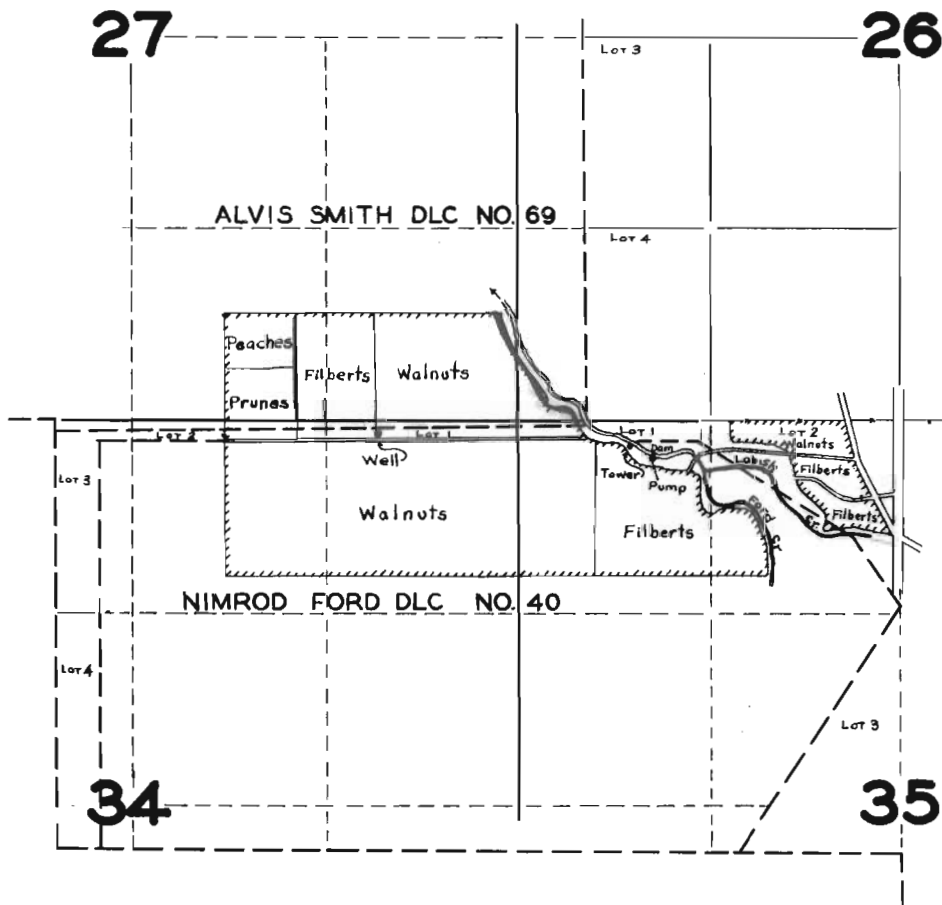

FINAL PROOF SURVEY
UNDER


Application No. 12212 Permit No. 8856

IN NAME OF

Chas. L. McNary & Walter T. Stolz

Surveyed July 10, 1942, by Geo. Maderman

TOWNSHIP 6 S., RANGE 3W.

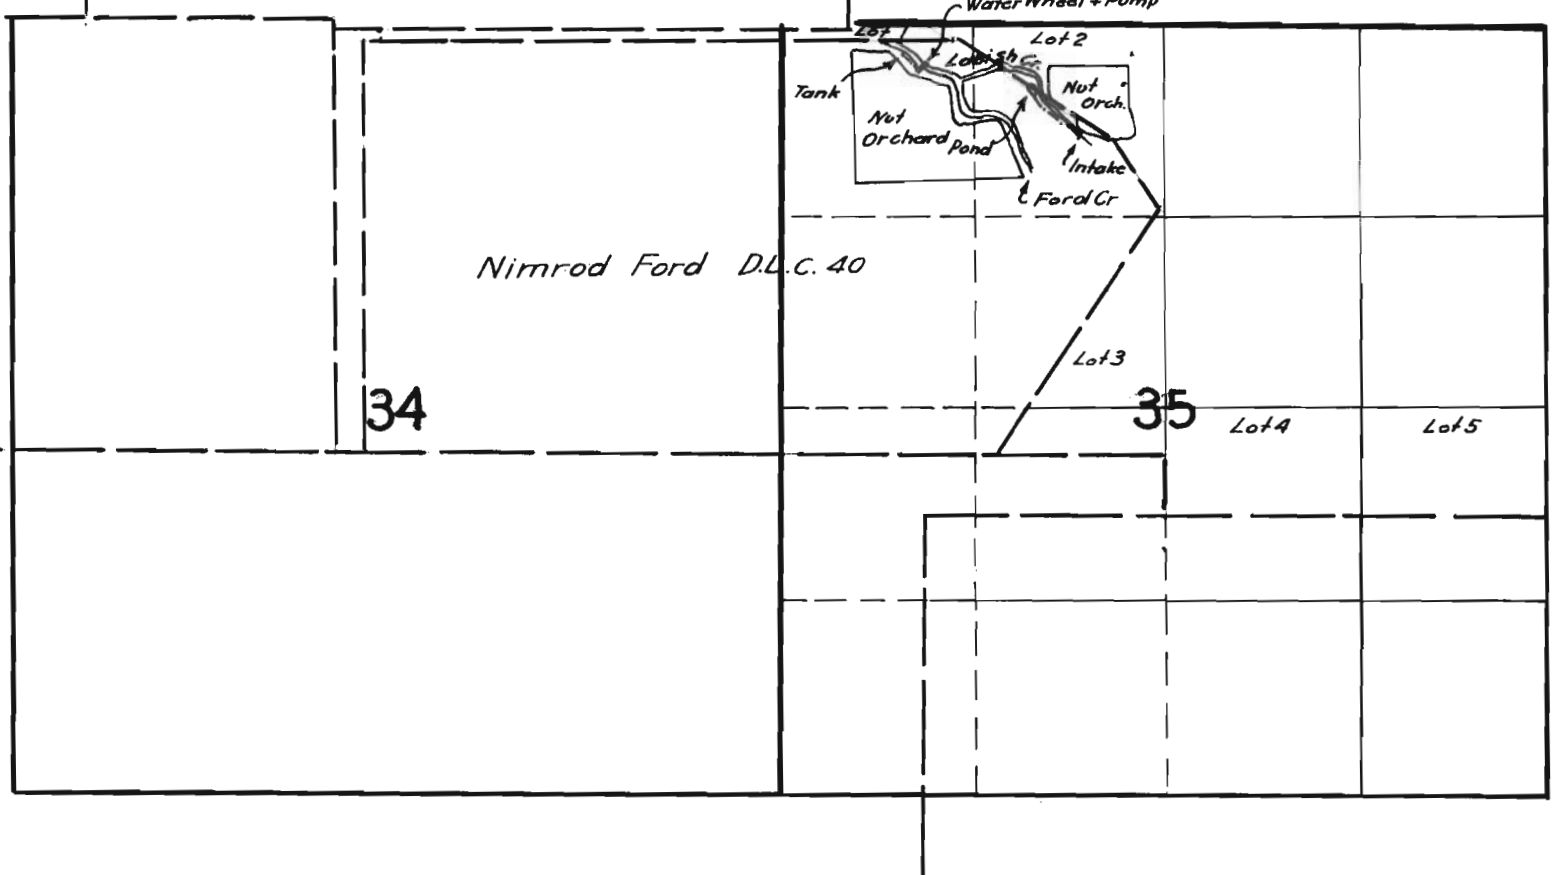

FINAL PROOF SURVEY
UNDER

Application No. 12212 Permit No. 8856

IN NAME OF

Charles L. McNary + Walter T. Stolz

Surveyed May 10 1941, by Blumming