


# T. 9 S. R. 1 W. W. M.

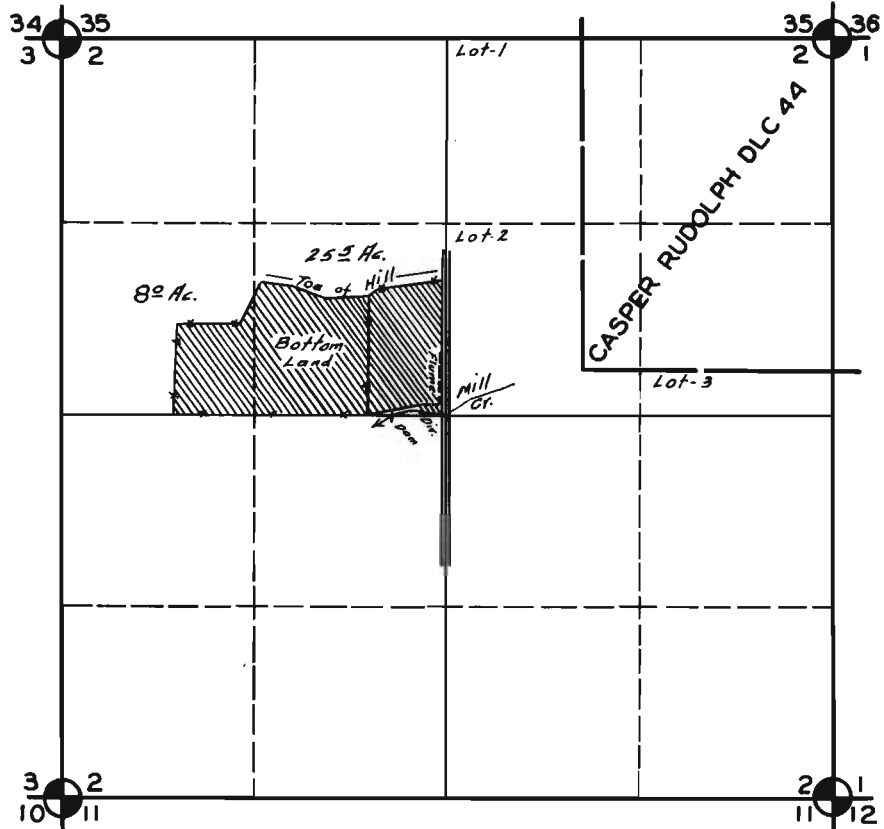

## FINAL PROOF SURVEY UNDER

Application No. 14518 Permit No. 10520

IN FAVOR OF

FRED HOTTINGER

Surveyed DEC. 16, 1944, by

*[Signature]*