


# T.3S. R. 2E.W.M.

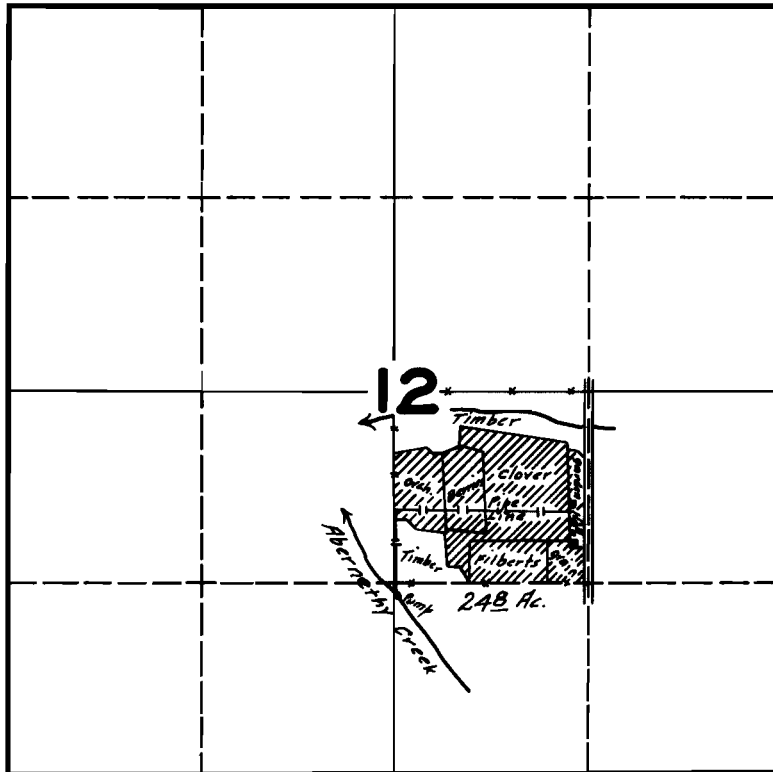

## FINAL PROOF SURVEY UNDER

Application No. 16103 Permit No. 11922

IN NAME OF

RAE A. ERICKSON

Surveyed AUG. 30 1944, by J. B. Bunnell