


# T.3S. R.2W.W.M.

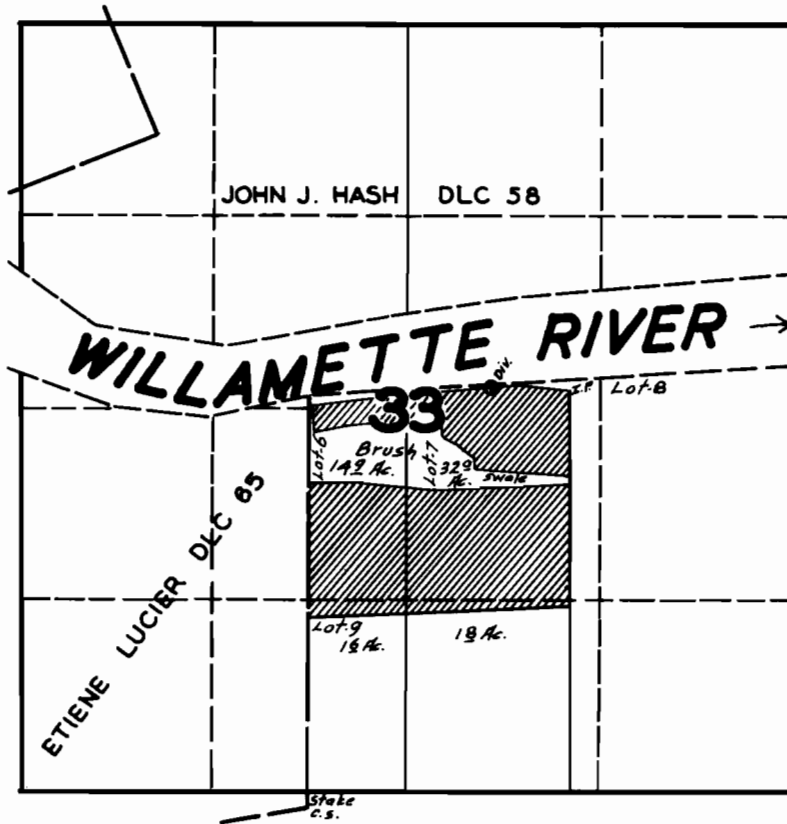

## FINAL PROOF SURVEY UNDER

Application No. 16776 Permit No. 12557

IN FAVOR OF

**GRACE E. GEARIN**

Surveyed DEC. 27 1944, by *[Signature]*