


T. 5S. R. 6W. W. M.

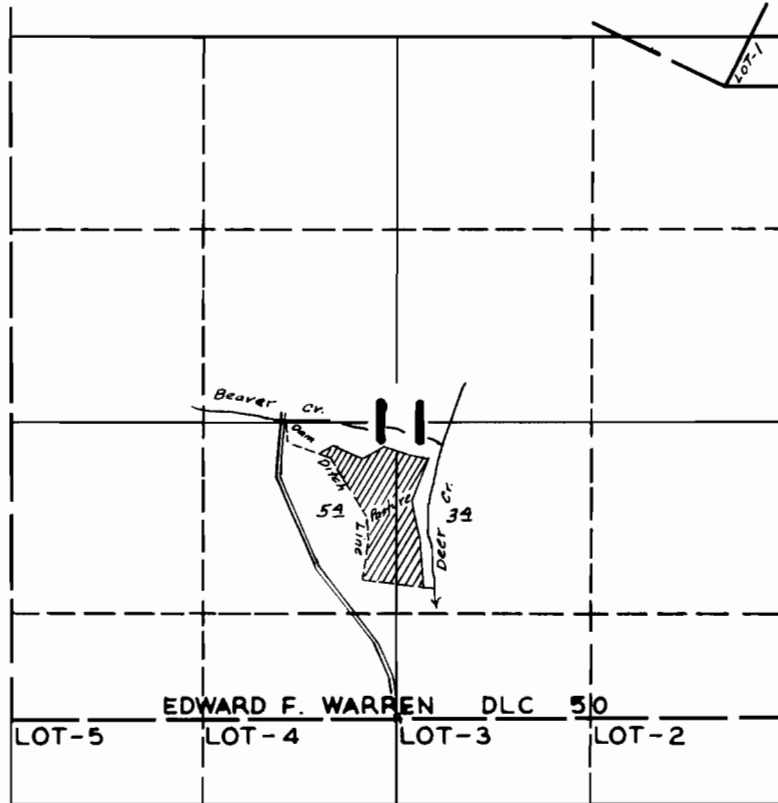

FINAL PROOF SURVEY

UNDER

Application No. 16816 Permit No. 12580

IN NAME OF

W. O. SIMS

Surveyed JULY 6 1944, by