


T.8S. R.6W.W.M.

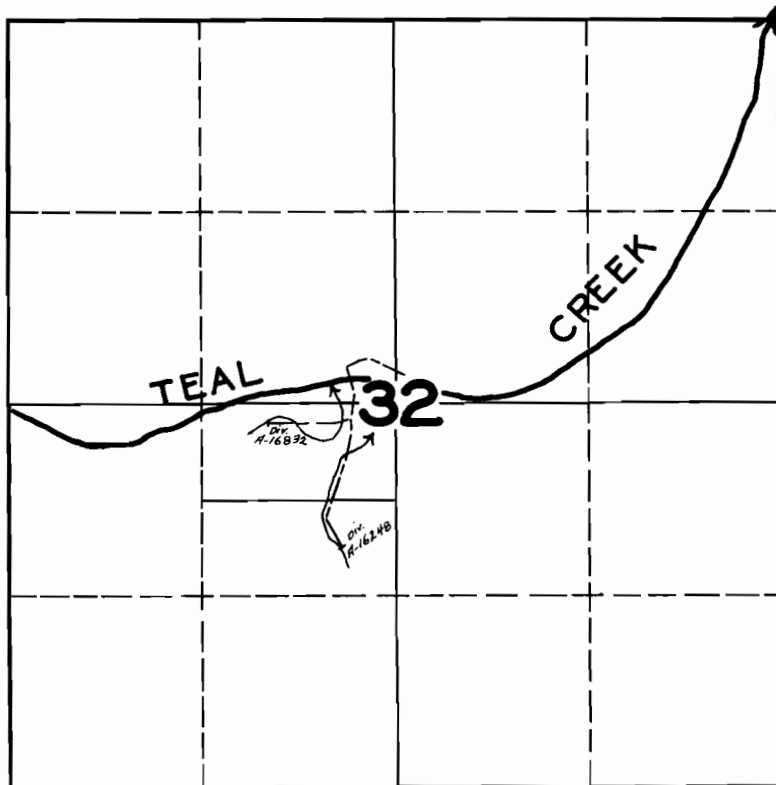

**FINAL PROOF SURVEY
UNDER**

Application No. 16832 Permit No. 12602

IN NAME OF

CITY OF MONMOUTH

Surveyed AUG. 18, 1944, by