


T. 2N. R. 4W. W.M.

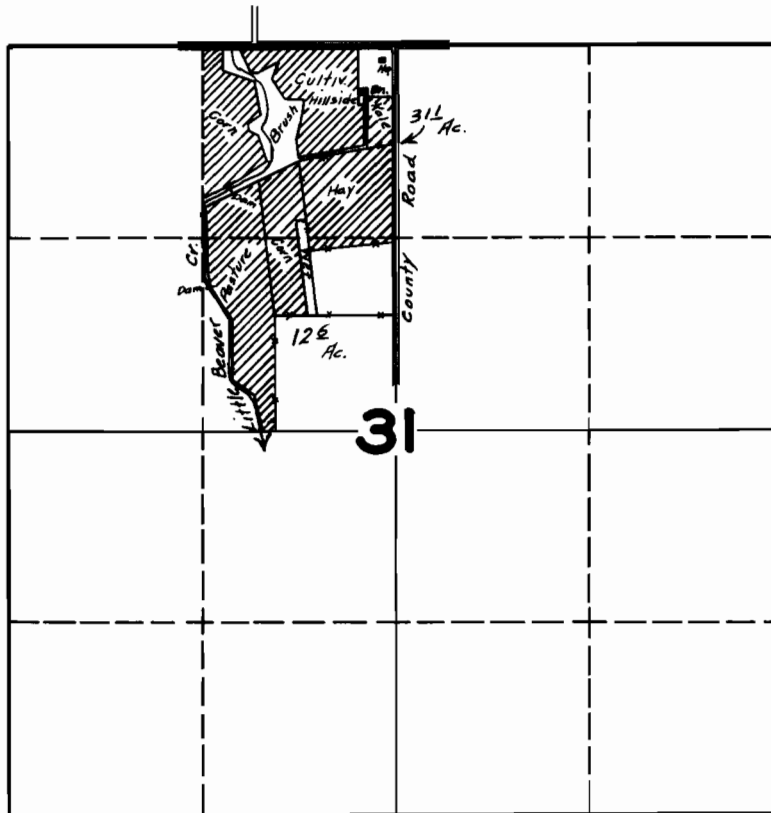

FINAL PROOF SURVEY UNDER

Application No. 17423 Permit No. 13118

IN NAME OF
E. D. WILSON

Surveyed JULY 27 1944, by