


T.6S. R.3W.W.M.

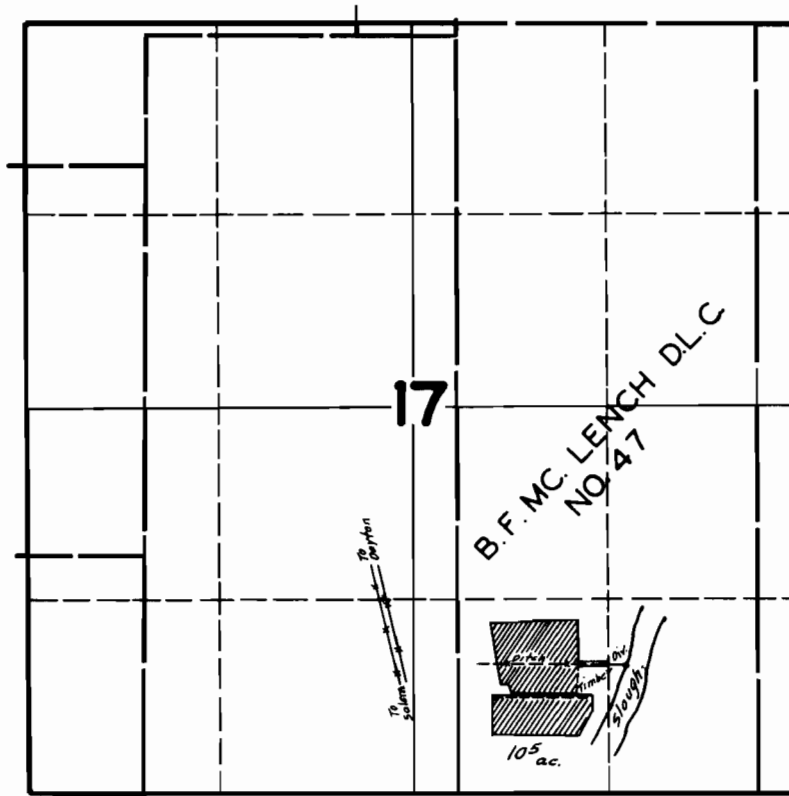

**FINAL PROOF SURVEY
UNDER**

Application No. 17506 Permit No. 13211

IN NAME OF

HOWARD M. TEEPLE

Surveyed MAY 18, 1945, by *[Signature]*