


T. 3 S. R. 4 W. W. M.

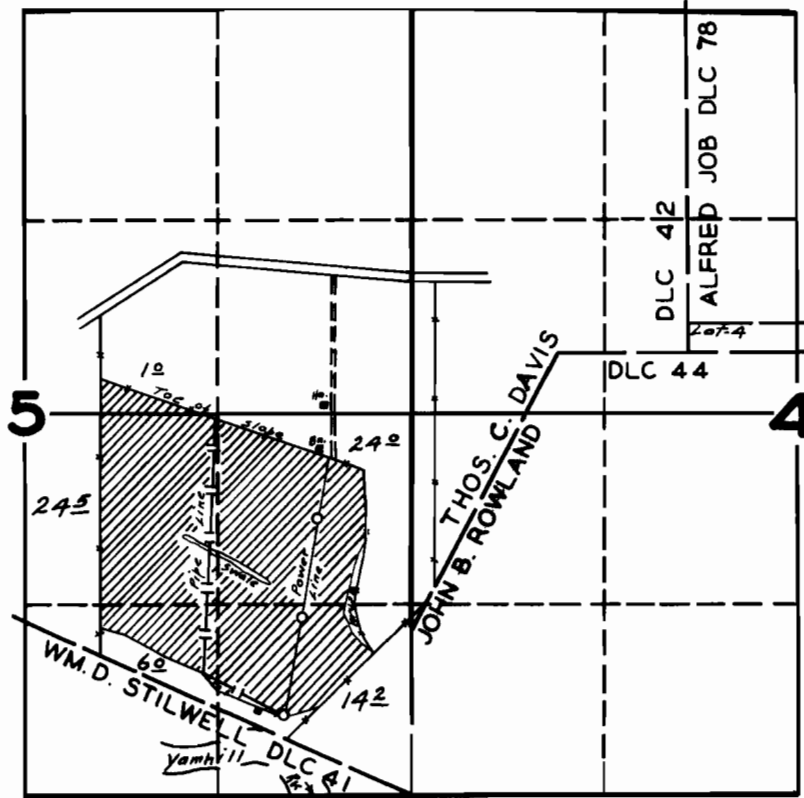

FINAL PROOF SURVEY

UNDER

Application No. 1752.4 Permit No. 13229

IN NAME OF

DR. HOWARD E. CARRUTH

Surveyed JUNE 30 1944, by