


T. 2N. R. 4W. W.M.

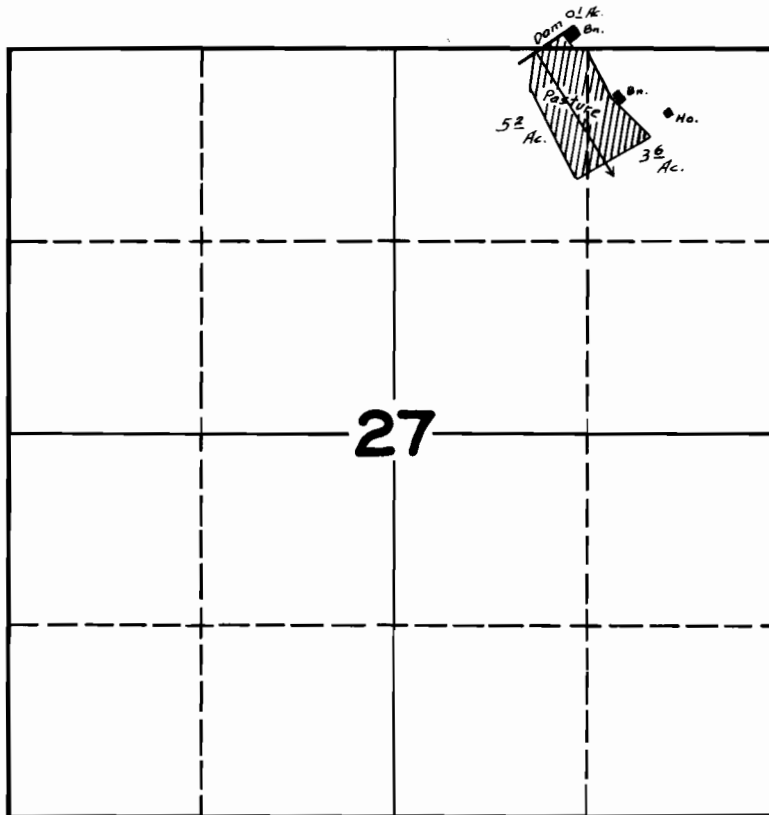

FINAL PROOF SURVEY UNDER

Application No. 17636 Permit No. 13334

IN NAME OF

R.M. & L.F. HOFER

Surveyed JULY 28 1944, by *J. B. Russell*