T.4S. R.4W.W.M.

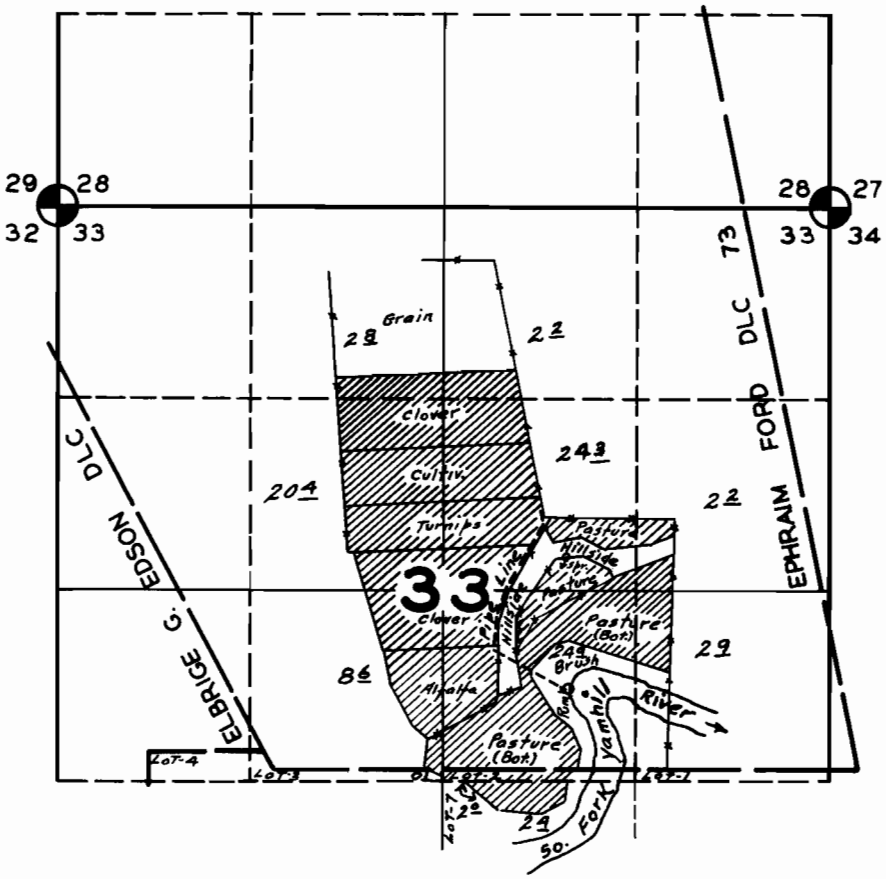

FINAL PROOF SURVEY

UNDER

Application No. 17664 Permit No. 13358

IN NAME OF

DICK REYNE

Surveyed JULY 11 1944, by James E. Burnell

1944 – C