


T.1N. R.3W.W.M.

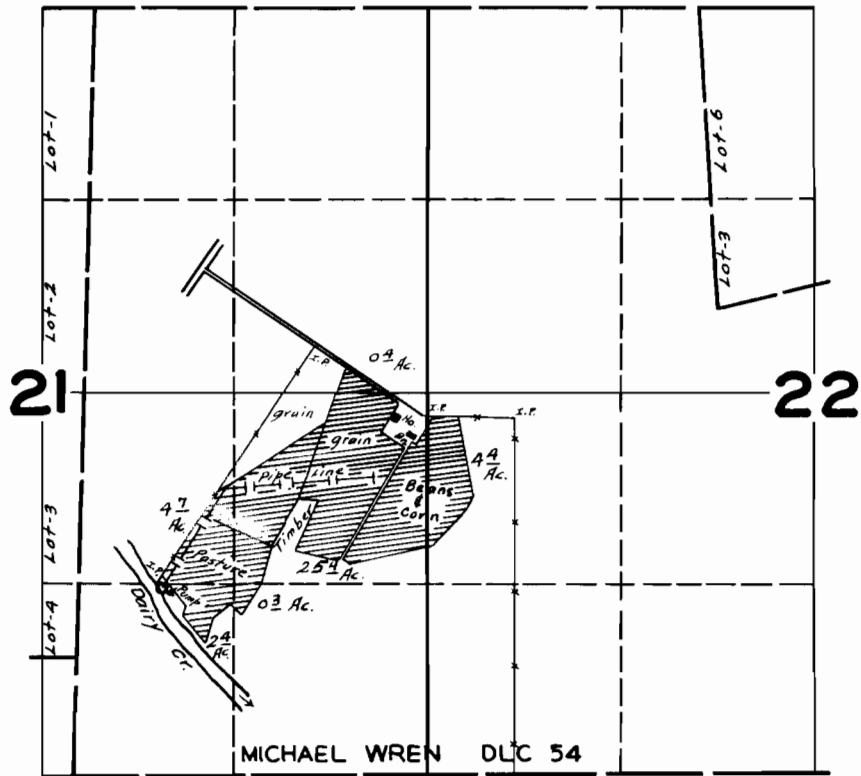

FINAL PROOF SURVEY

UNDER

Application No. 17733 Permit No. 13399

IN NAME OF

UNITED STATES OF AMERICA

Surveyed AUG. 1 1944 by

James B. Sumrell