


T. IS. R. 4. W. W. M.

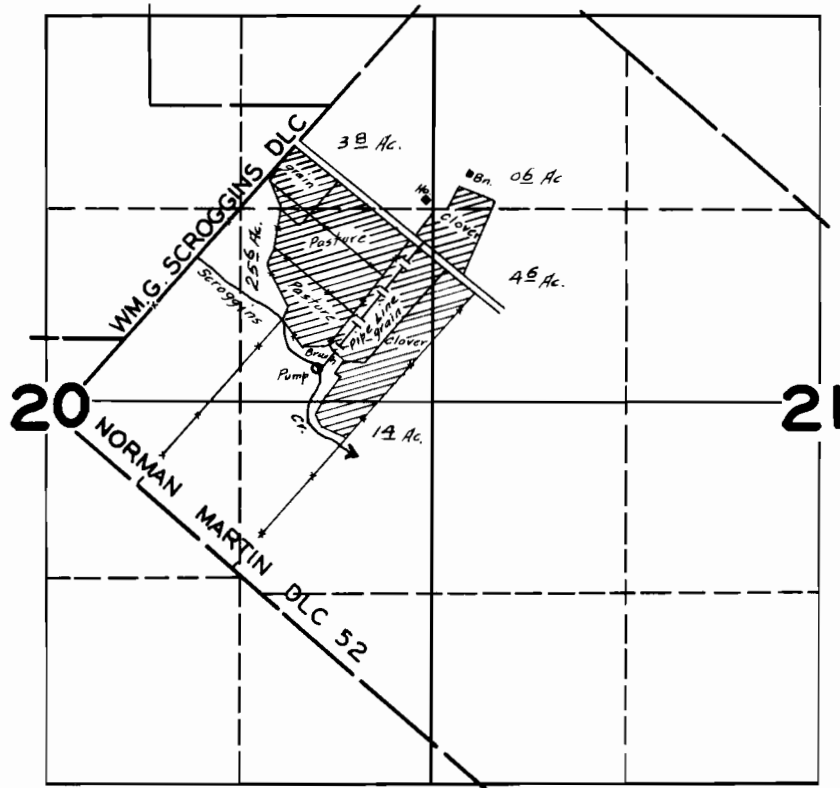

FINAL PROOF SURVEY UNDER

Application No. 17744 Permit No. 13439

IN NAME OF

ARTHUR KNOX & SONS

Surveyed JULY 24 1944, by