


T. IS. & IN. R. 4 W. W. M.

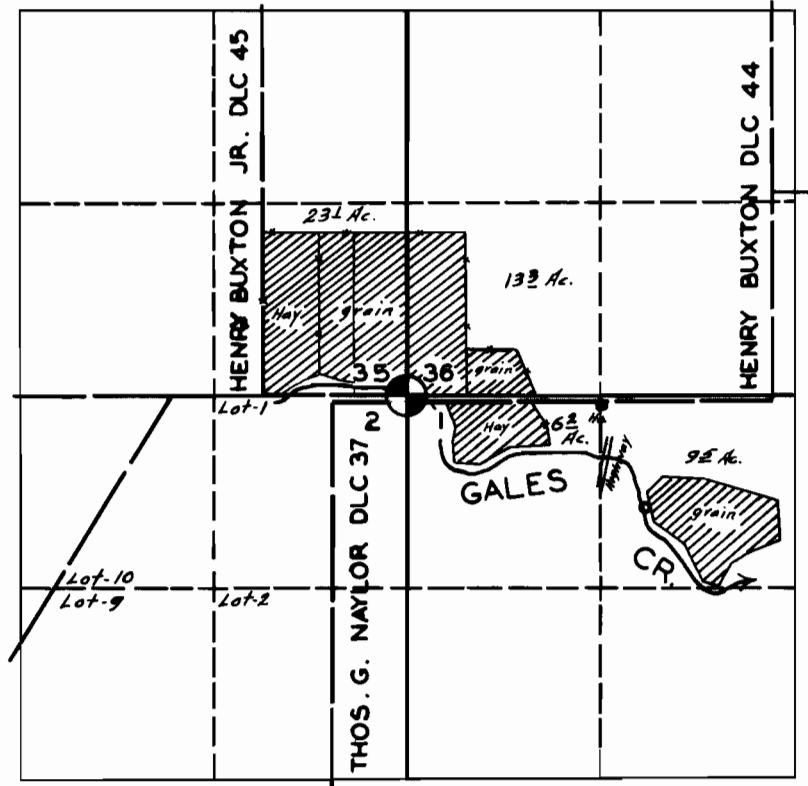

FINAL PROOF SURVEY UNDER

Application No. 17778 Permit No. 13463

IN NAME OF

FRANCIS DUYCK

Surveyed JULY 26 1944, by [Signature]