


T.9 S. R.I W. W.M.

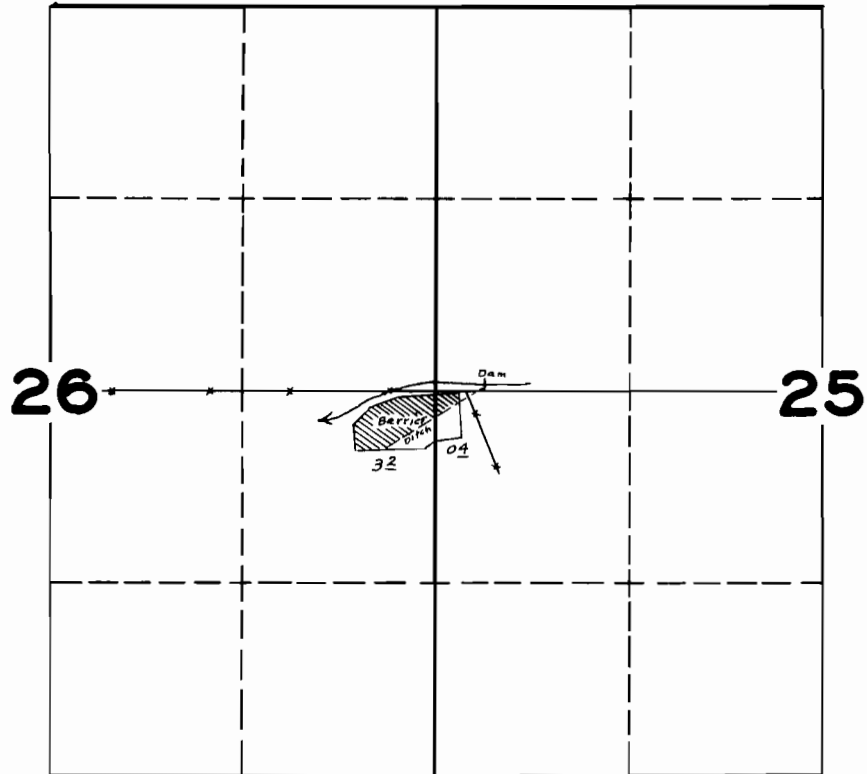

FINAL PROOF SURVEY

UNDER

Application No. 17799 Permit No. 13478

IN NAME OF

WALTER DOZLER

Surveyed SEPT. 11 1944, by

James C. Runnel