


T.5S. R.3W.W.M.

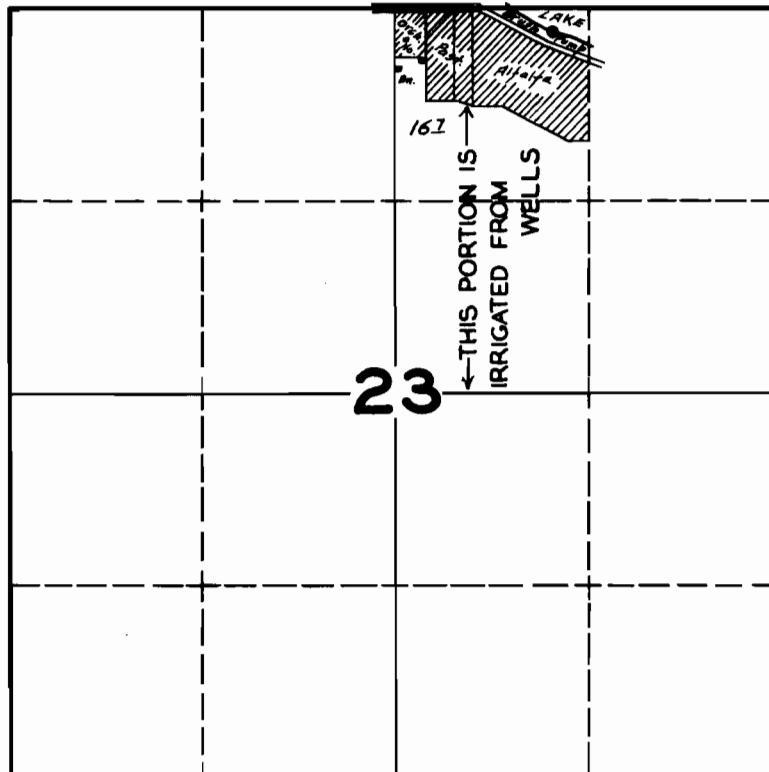

**FINAL PROOF SURVEY
UNDER**

Application No. 17884 Permit No. 13512

IN NAME OF

CHAS. A. FERGUSON

Surveyed JULY 1, 1944, by *James D. Sumrell*