


T.5S. R.6W.W.M.

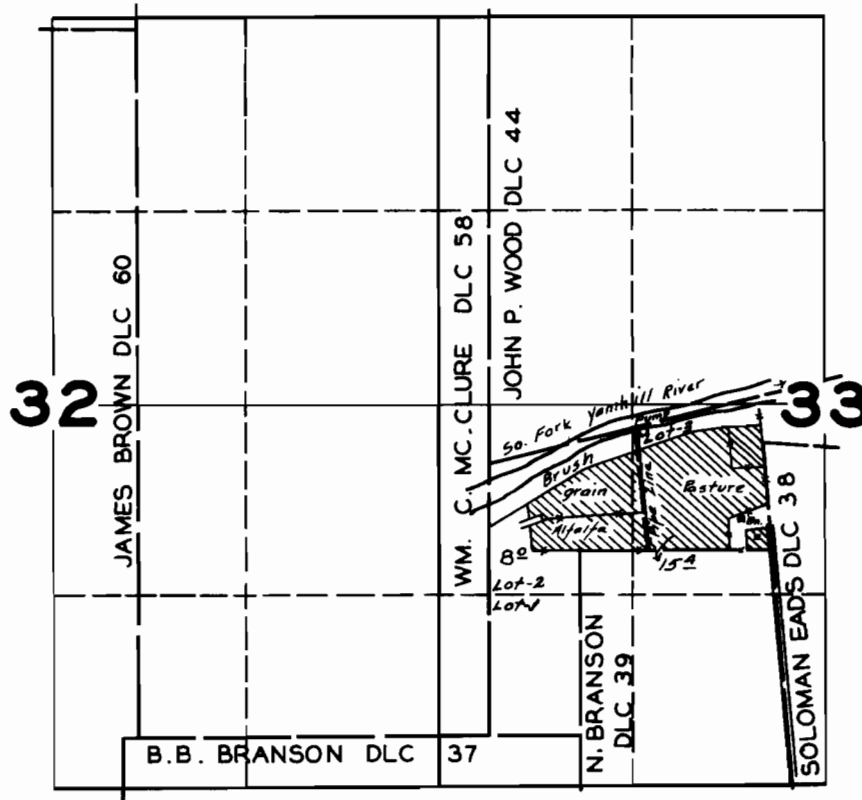

FINAL PROOF SURVEY UNDER

Application No. 17856 Permit No. 13538

IN NAME OF
AMOS O. HENTON

Surveyed JULY 6 1944 by

James E. Burnett