


T.3S. R.3E.W.M.

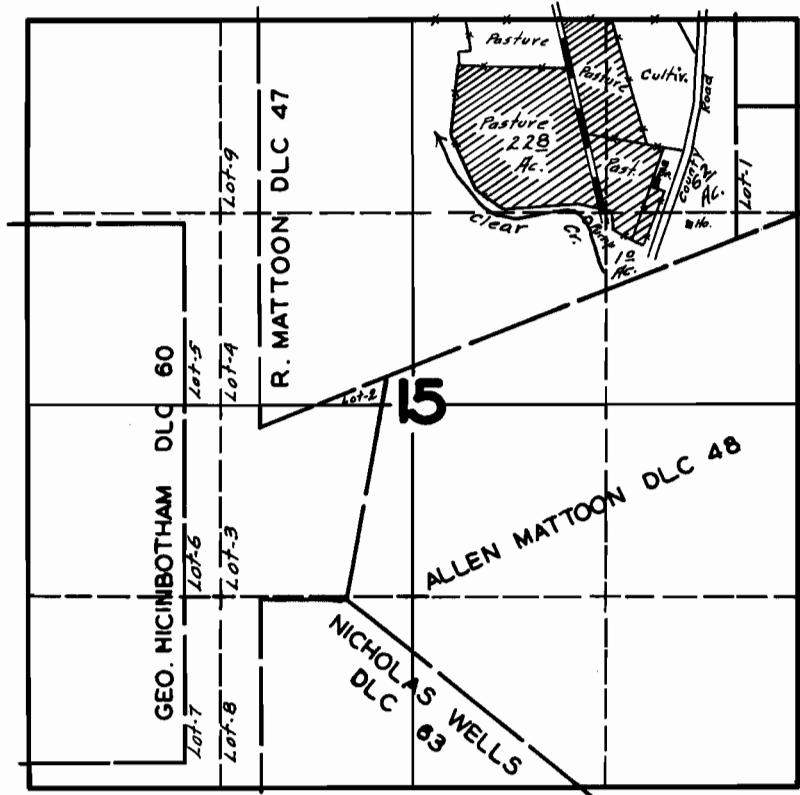

FINAL PROOF SURVEY UNDER

Application No. 17863 Permit No. 13544

IN NAME OF

ROY-LAMB & COMPANY

Surveyed AUG. 29 1944, by *[Signature]*