


T.2S. R.3E.W.M.

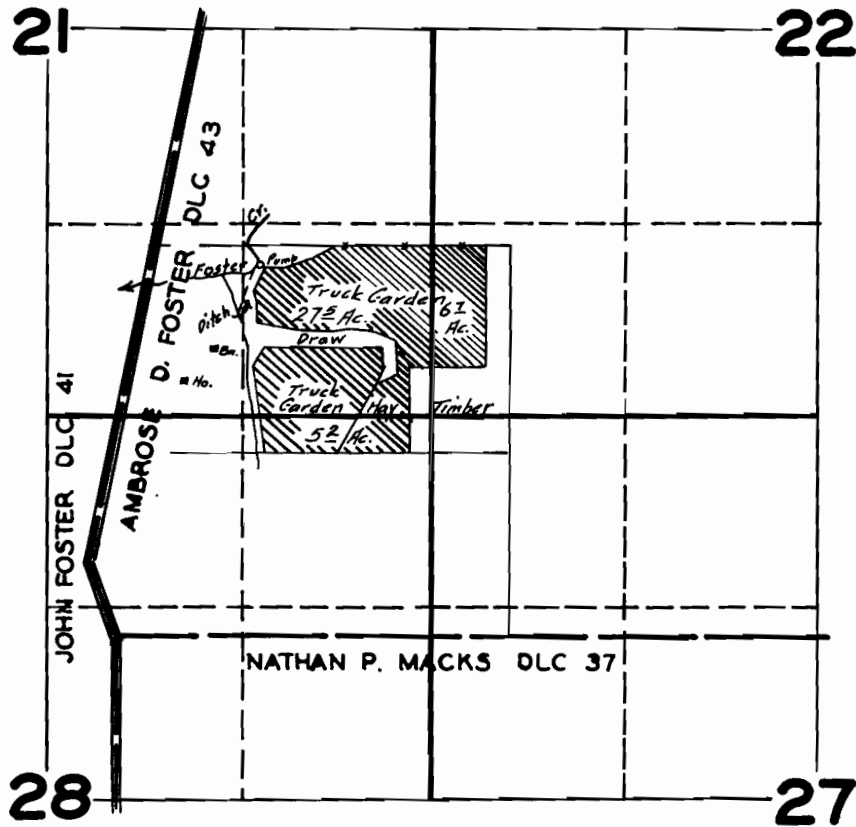

FINAL PROOF SURVEY

UNDER

Application No. 16835 17803 Permit No. 12595 13574

IN NAME OF

JOHN MOSTUL

Surveyed AUG. 29 1944, by *[Signature]*