


T.8N. R.9W.W.M.

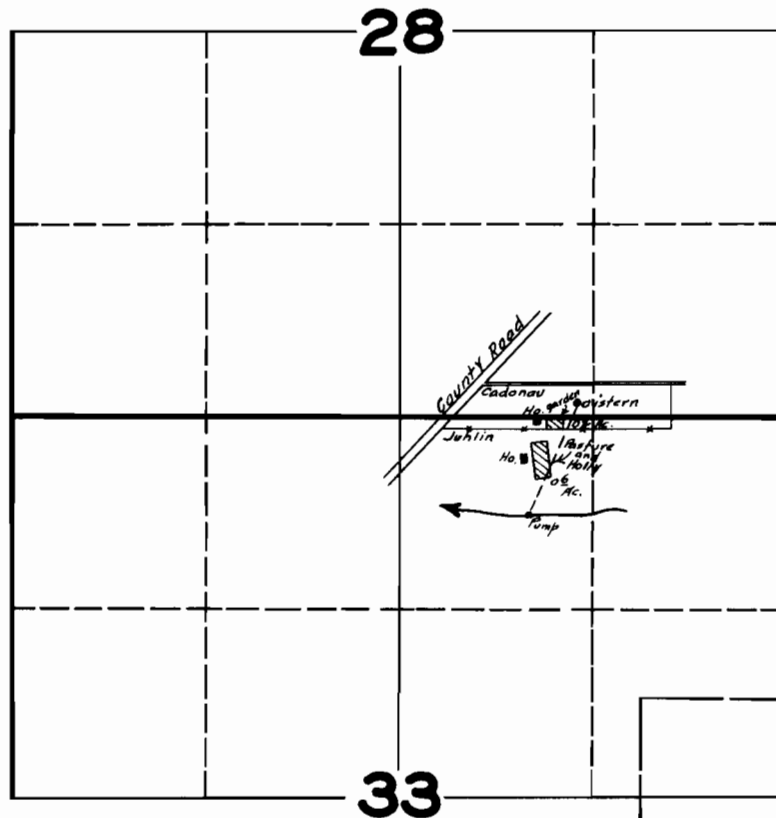

FINAL PROOF SURVEY
UNDER

Application No. 18080 Patent No. 13627

LEE & EDITH CADONAU & KENNETH & MARY JUHLIN

Surveyed AUG. 10 1944, by

1944 - F