


T. 2N. R. 5W. W.M.

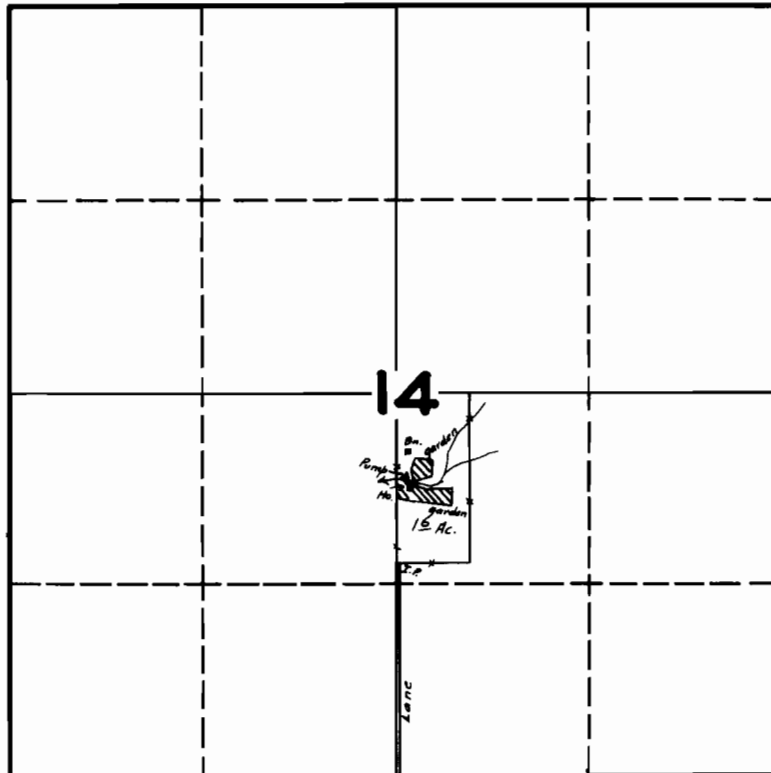

FINAL PROOF SURVEY
UNDER

Application No. 17955 Permit No. 13634

IN NAME OF

AUGUST HINRICHS

Surveyed JULY 18 1944, by *James E. Russell*