


T. 4S. R. 3W. W.M.

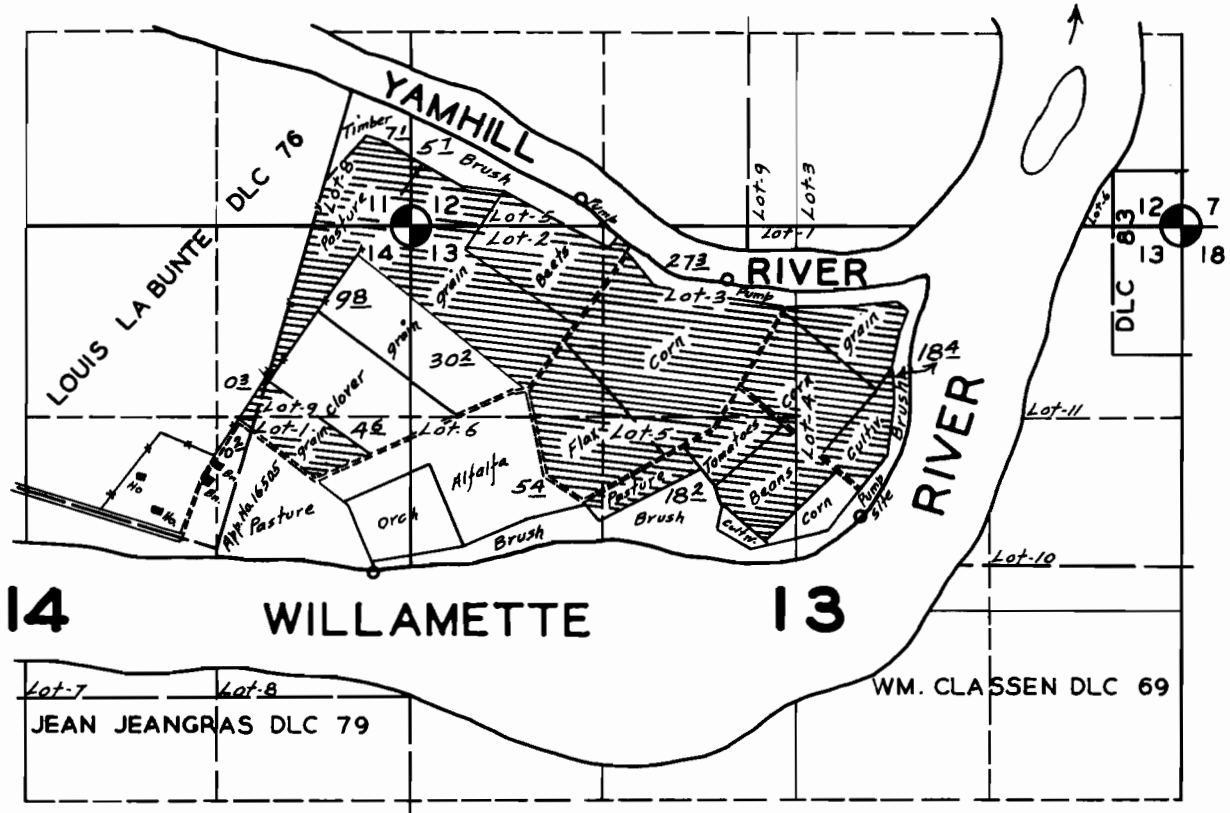

FINAL PROOF SURVEY UNDER

Application No. 18015 Permit No. 13687
IN NAME OF
L.S. LORENZEN

Surveyed JULY 13 1944, by *J. B. Russell*