


T. 4S. R. 4W. W.M.

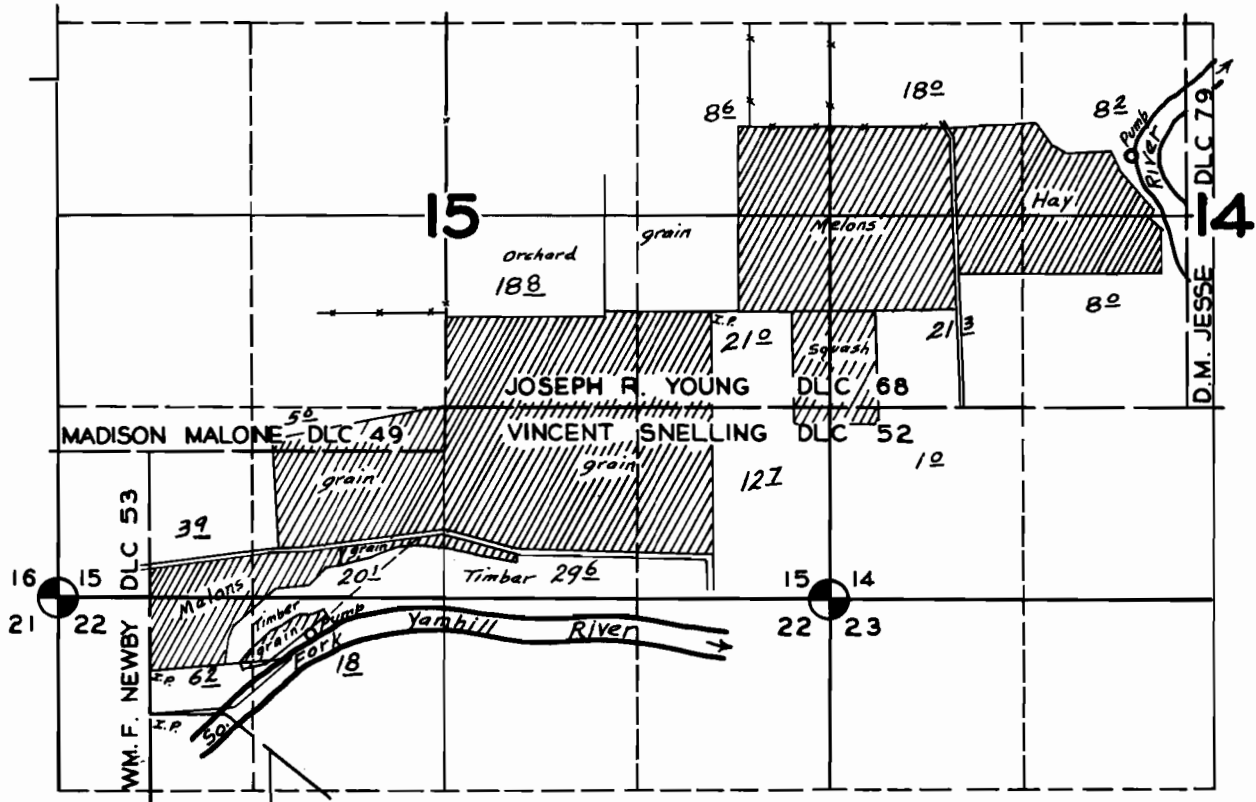

FINAL PROOF SURVEY UNDER

Application No. 18614 Permit No. 14252

IN NAME OF
MILLER BROTHERS

Surveyed SEPT. 8 1944, by *James P. Russell*